


o.c. FOR 2nd FLOOR (P) + Ground (P) + 1st Floor & 2nd Floor
(Remaining Part) only.

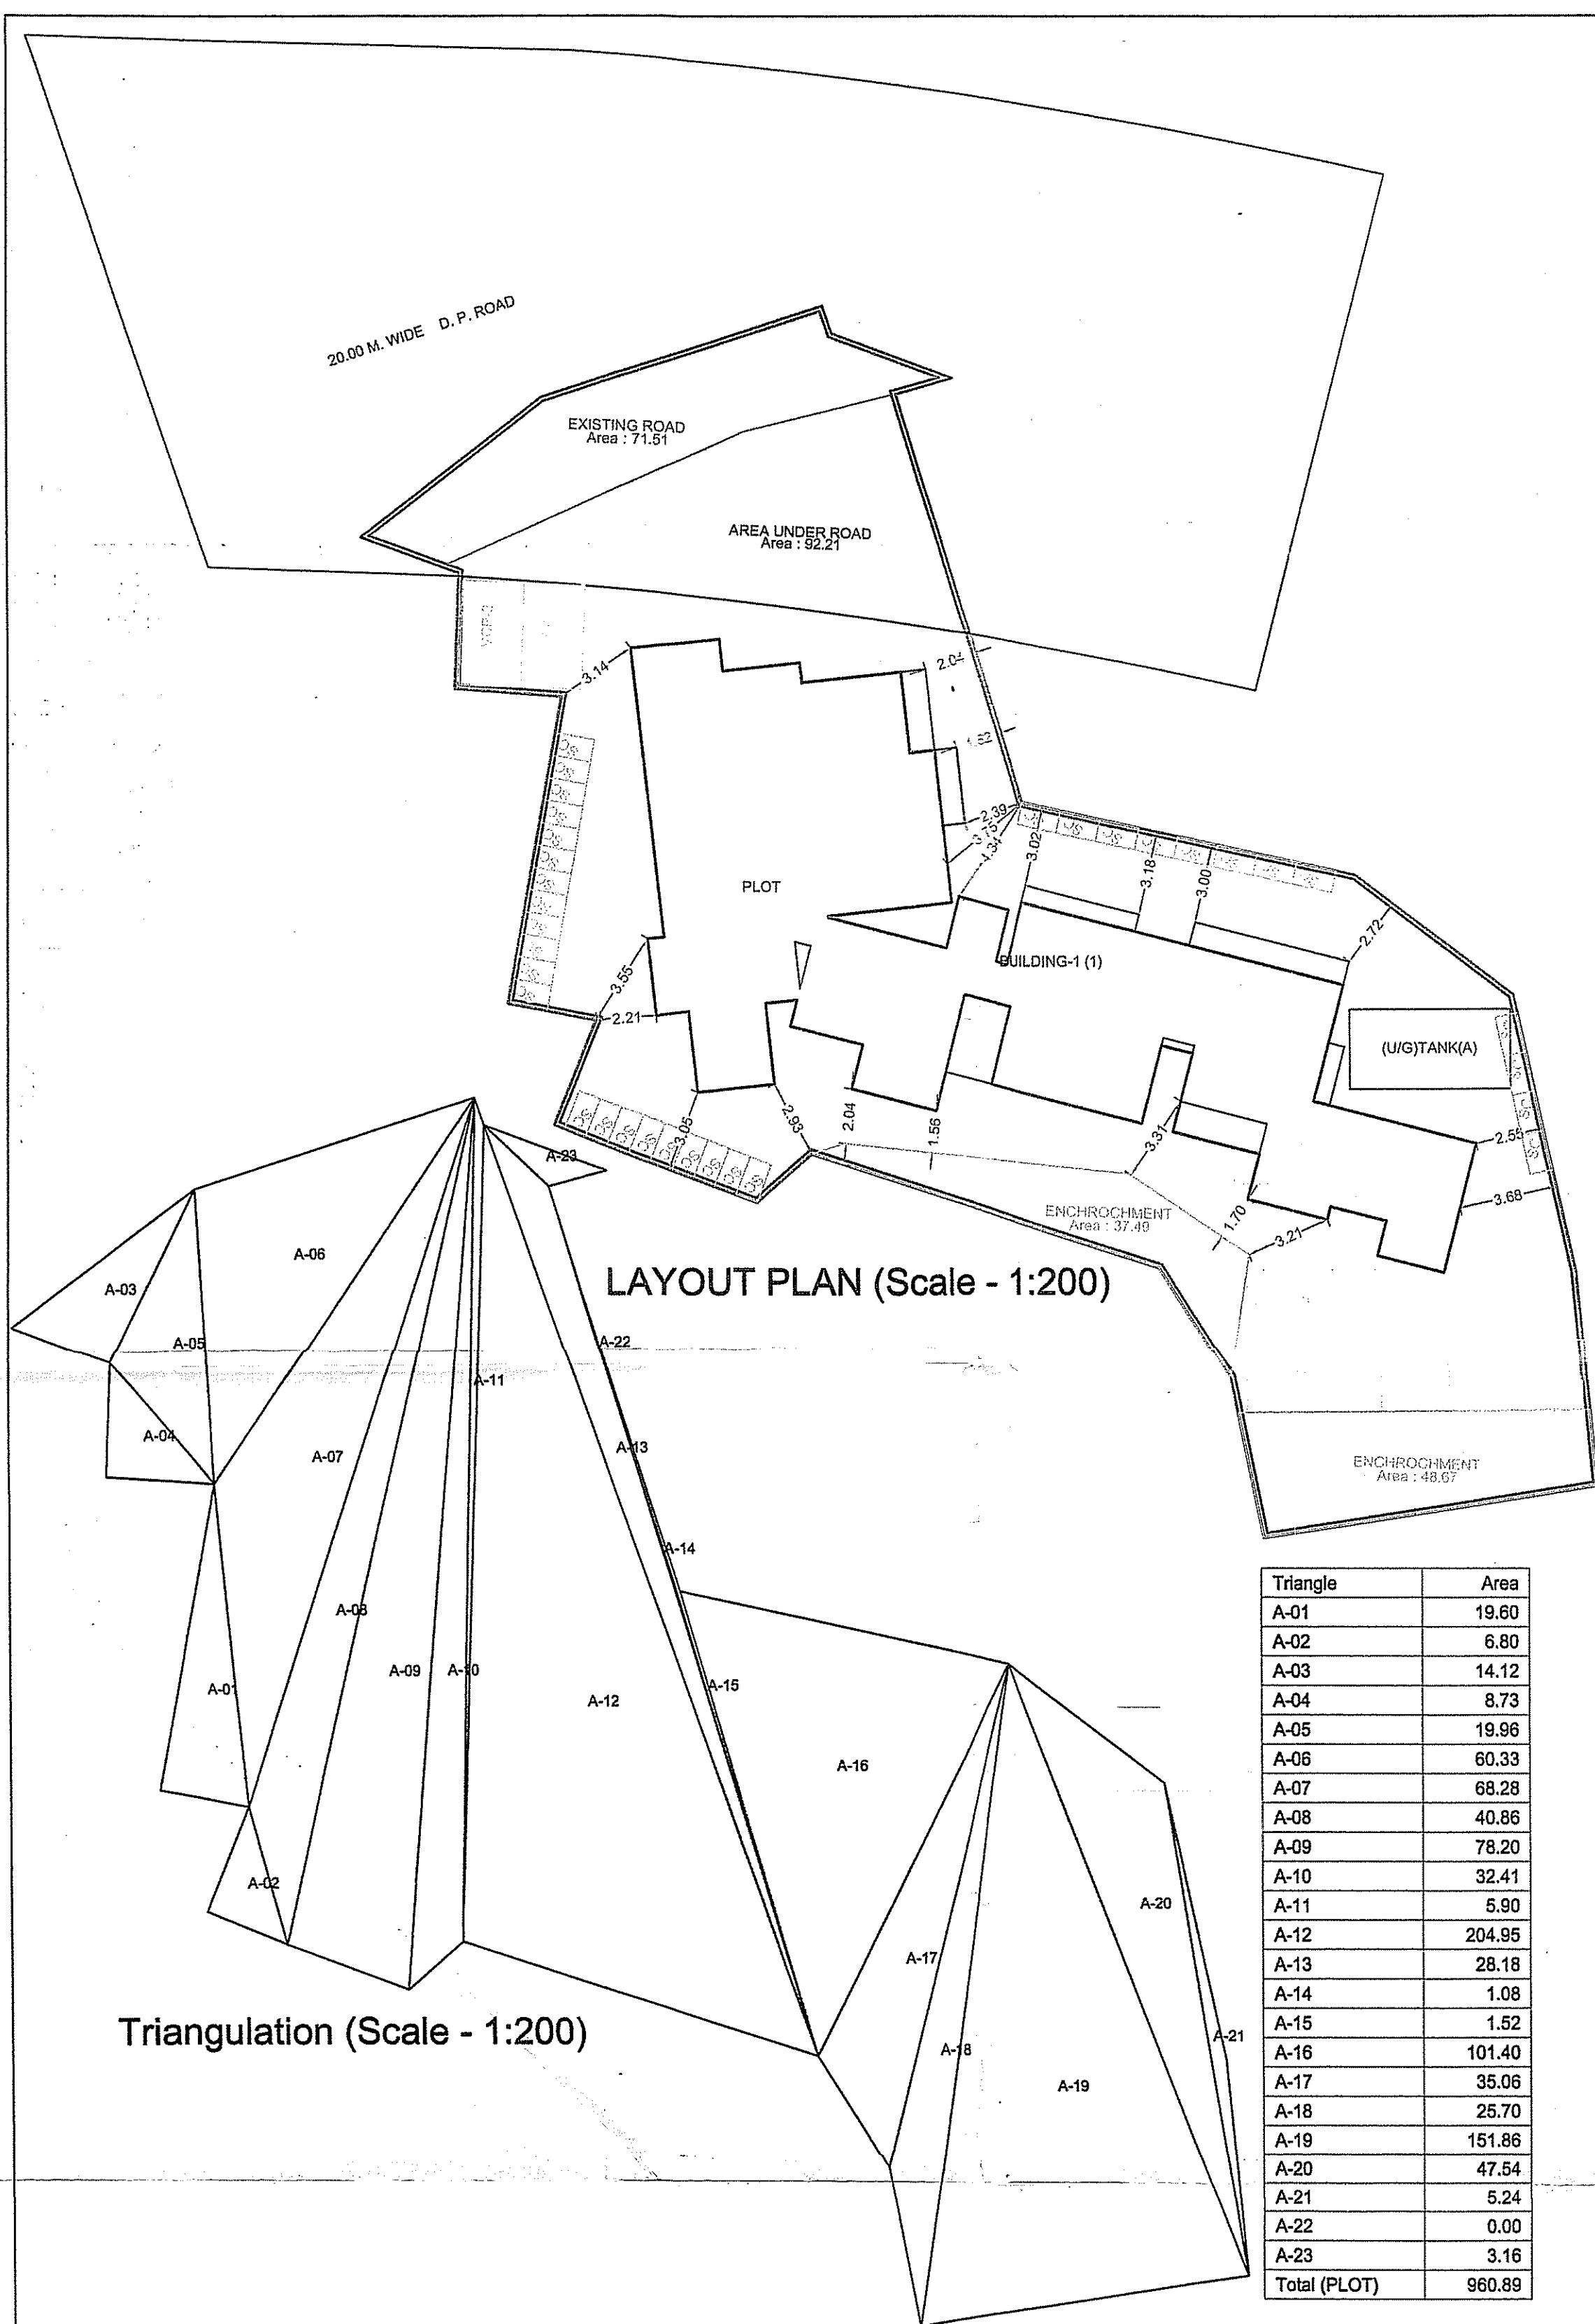

AREA STATEMENT (AS BUILT PLAN)			SQ.MT.
1	AREA OF PLOT (144.00+816.80)	960.80	
2	AREA UNDER ROAD		
(a)	area under proposed Road	92.17	
(b)	Existing Road Area	71.49	
(c)	Area Under Encroachment	86.20	
	TOTAL (a+b+c)	249.86	
3	Balance area of plot (1minus2)	710.94	
4	Permissible Area	^a Resi. (5x 1.50) b.Comm. (5x0.5)	
		710.94x1.5=1066.41 710.94x0.5=355.47	
5	Permissible Road Area 92.17proposed Road	92.17x3x0.75=207.38 92.17x3x0.25=69.12	
6	Add Road Area	= 207.38 0.00	
7	Addition for F.S.I. credit Permissible by development Rights As per Govt.Gr. dated 29.01.16 (1.4) on balance plot area = 710.94 sq.mtr. 710.94 x 0.90 =639.84 sq.mtr. out of above potential of TDR area Slum TDR 639.84 x 20%=127.96sq.mtr. Regular TDR 639.84 -127.96=511.88sq.mtr.		
8	Proposed D.R. Area (Sr.No.6)	= 207.38 0.00	
9	As per indexation A) Add. for DRC No.369 (Road) 305.00 x 21400 =305.00 sq.mtr 21400 B) Add. for DRC No.10(Slum) 18.00 x 36700 =30.80 sq.mtr 21400		
10	A)PROPOSED Regular TDR	= 304.50	
11	B)PROPOSED Slum TDR	= 30.80	
11	TOTAL PROPOSED (TDR+DR)(8+10A + 10B)	542.68	
12	TOTAL PERMISSIBLE AREA (4+11)	1609.09 355.47	
13	TOTAL PERMISSIBLE	1964.56 SQ.MT	
14	TOTAL PROPOSED AREA	1602.43 101.87	
15	TOTAL PROPOSED	1704.30 SQ.MT	

SCHEDULE OF OPENING: BUILDING (1)

NAME	WIDTH	HEIGHT	NOS.
D2	0.60	2.10	07
D3	0.75	2.10	71
D2	0.75	2.10	05
D1	0.90	2.10	113
D1	0.95	2.10	02
D	1.00	2.10	02
D	1.05	2.10	40
RS	2.75	2.10	01
RS	3.00	2.10	01
RS	3.60	2.10	01

SCHEDULE OF OPENING: BUILDING (1)

NAME	WIDTH	HEIGHT	NOS.
V	0.60	0.60	83
V	0.60	1.20	02
W	1.18	1.20	07
W	1.20	1.20	21
W	1.35	1.20	102
W	1.80	1.20	11

PARKING CALCULATION

TYPE	CARPET AREA/ FSI (M2)	TENEMENT (NOS)	CAR (NOS)	SCOOTER (NOS.)	SCOOTER (NOS.)	SCOOTER (NOS.)	SCOOTER (NOS.)	SCOOTER (NOS.)	SCOOTER (NOS.)
Residential	BUA: 0 - 35	1	9	0	0	0	0	0	0
Residential	BUA: 35 - 50	2	26	1	13	1	26	1	1
Residential	BUA: 50 - 75	1	7	1	7	1	7	1	1
Residential	BUA: > 75	1	0	2	0	1	0	1	1
Commercial	FSI: 0 - 400	25	101.87	1	4	1	5	1	1
Commercial	FSI: > 400	50	0	1	0	1	0	1	1
Total	Required	-	-	-	24	-	38	-	38
Total	Proposed	-	-	-	20	-	-	-	-

DETAILS OF TDR

A)Max Permissible 0.90 TDR on (710.94x0.90=639.84 sq.mtr. Slum TDR (639.84x20%=127.96 sq.mtr.)
B)Max Permissible Regular TDR 639.84-127.96=511.88sq.mtr.
*Add TDR/DR
A)Proposed Road DR area (Sr.8)=207.38 sq.mtr.
B)ADD for DRC NO.369,(Road)=304.50 sq.mtr.
TOTAL (A+B) = 511.88 sq.mtr.
*Add Slum TDR
DRC NO.10(Slum) = 30.80 sq.mtr.
TOTAL (1+2) = 511.88 + 30.80=542.68sq.mtr

FLOOR WISE FSI STATEMENT: BUILDING (1)

FLOORS	COMM.	RESI.	IND.	SPEC.	PERM.	PROP.	EXCESS	PASSAGE	FREE OF FSI	FREE OF FSI	TERRACE	LIFT M/C ROOM	TENEMENTS	TOTAL FSI AREA
GROUND FLOOR	101.87	0.00	0.00	0.00	0.00	0.00	0.00	000.00	31.70	3.97	000.00	-	0	101.87
FIRST FLOOR	0.00	221.48	0.00	0.00	22.15	19.84	0.00	000.00	31.84	3.97	000.00	-	6	221.48
SECOND FLOOR	0.00	221.48	0.00	0.00	22.15	19.84	0.00	000.00	31.84	3.97	000.00	-	6	221.48
THIRD FLOOR	0.00	232.37	0.00	0.00	23.24	23.08	0.00	000.00	12.04	3.97	000.00	-	6	232.37
FOURTH FLOOR	0.00	232.37	0.00	0.00	23.24	23.08	0.00	000.00	12.04	3.97	000.00	-	6	232.37
FIFTH FLOOR	0.00	232.37	0.00	0.00	23.24	23.08	0.00	000.00	12.04	3.97	000.00	-	6	232.37
SIXTH FLOOR	0.00	232.37	0.00	0.00	23.24	23.08	0.00	000.00	12.04	3.97	000.00	-	6	232.37
SEVENTH FLOOR	0.00	232.37	0.00	0.00	23.24	23.08	0.00	000.00	12.04	3.97	000.00	-	6	232.37
TERRACE FLOOR	0.00	0.00	0.00	0.00	0.00	0.00	0.00	000.00	0.00	0.00	000.00	0.00	0	0.00
Total	101.87	1604.78	0.00	0.00	160.48	154.67	0.00	000.00	155.58	31.76	000.00	3.97	42	1706.65

BUILDING WISE FSI STATEMENT

BUILDING	COMM.	RESI.	IND.	SPEC.	PERM.	PROP.	EXCESS	PASSAGE	FREE OF FSI	FREE OF FSI	TERRACE	LIFT M/C ROOM	TENEMENTS	TOTAL FSI AREA
BUILDING-1 (1)	101.87	1604.78	0.00	0.00	160.48	154.67	0.00	000.00	155.58	31.76	000.00	3.97	42	1706.65
Total	101.87	1604.78	0.00	0.00	160.48	154.67	0.00	000.00	155.58	31.76	000.00	3.97	42	1706.65

FLOOR WISE FSI STATEMENT: BUILDING (1) AS BUILT PLAN

FLOORS	COMM.	RESI.	IND.	SPEC.	PERM.	PROP.	EXCESS	PASSAGE	FREE OF FSI	FREE OF FSI	TERRACE	LIFT M/C ROOM	TENEMENTS	TOTAL FSI AREA
GROUND FLOOR	101.87	0.00	0.00	0.00	0.00	0.00	0.00	000.00	31.70	3.97	000.00	-	0	101.87
FIRST FLOOR	0.00	220.09	0.00	0.00	22.15	19.84	0.00	000.00	31.84	3.97	000.00	-	6	220.09
SECOND FLOOR	0.00	220.49	0.00	0.00	22.15	19.84	0.00	000.00	31.84	3.97	000.00	-	6	220.49
THIRD FLOOR	0.00	232.37	0.00	0.00	23.24	23.08	0.00	000.00	12.04	3.97	000.00	-	6	232.37
FOURTH FLOOR	0.00	232.37	0.00	0.00	23.24	23.08	0.00	000.00	12.04	3.97	000.00	-	6	232.37
FIFTH FLOOR	0.00	232.37	0.00	0.00	23.24	23.08	0.00	000.00	12.04	3.97	000.00	-	6	232.37
SIXTH FLOOR	0.00	232.37	0.00	0.00	23.24	23.08	0.00	000.00	12.04	3.97	000.00	-	6	232.37
SEVENTH FLOOR	0.00	232.37	0.00	0.00	23.24	23.08	0.00	000.00	12.04	3.97	000.00	-	6	232.37
TERRACE FLOOR	0.00	0.00	0.00	0.00	0.00	0.00	0.00	000.00	0.00	0.00	000.00	0.00	0	0.00
Total	101.87	1602.43	0.00	0.00	160.48	154.67	0.00	000.00	155.58	31.76	000.00	3.97	42	1704.30

BUILDING WISE FSI STATEMENT

BUILDING	COMM.	RESI.	IND.	SPEC.	PERM.	PROP.	EXCESS	PASSAGE	FREE OF FSI	FREE OF FSI	TERRACE	LIFT M/C ROOM	TENEMENTS	TOTAL FSI AREA
BUILDING-1 (1)	101.87	1602.43	0.00	0.00	160.48	154.67	0.00	000.00	155.58	31.76	000.00	3.97	42	1704.30
Total	101.87	1602.43	0.00	0.00	160.48	154.67	0.00	000.00	155.58	31.76	000.00	3.97	42	1704.30

AREA STATEMENT (SANCTIONED)			SQ.MT.
1	AREA OF PLOT (144.00+816.80)	960.80	
2	AREA UNDER ROAD		
(a)	area under proposed Road	92.17	
(b)	Existing Road Area	71.49	
(c)	Area Under Encroachment	86.20	
	TOTAL (a+b+c)	249.86	
3	Balance area of plot (1minus2)	710.94	
4	Permissible Area	^a Resi. (5x 1.50) b.Comm. (5x0.5)	
		710.94x1.5=1066.41 710.94x0.5=355.47	
5	Permissible Road Area 92.17proposed Road	92.17x3x0.75=207.38 92.17x3x0.25=69.12	
6	Add Road Area	= 207.38 0.00	
7	Addition for F.S.I. credit Permissible by development Rights As per Govt.Gr. dated 29.01.16 (1.4) on balance plot area = 710.94 sq.mtr. 710.94 x 0.90 =639.84 sq.mtr. out of above potential of TDR area Slum TDR 639.84 x 20%=127.96sq.mtr. Regular TDR 639.84 -127.96=511.88sq.mtr.		
8	Proposed D.R. Area (Sr.No.6)	= 207.38 0.00	
9	As per indexation A) Add. for DRC No.369 (Road) 305.00 x 21400 =305.00 sq.mtr 21400 B) Add. for DRC No.10(Slum) 18.00 x 36700 =30.80 sq.mtr 21400		
10	A)PROPOSED Regular TDR	= 304.50	
11	B)PROPOSED Slum TDR	= 30.80	
11	TOTAL PROPOSED (TDR+DR)(8+10A + 10B)	542.68	
12	TOTAL PERMISSIBLE AREA (4+11)	1609.09 355.47	
13	TOTAL PERMISSIBLE	1964.56 SQ.MT	
14	TOTAL PROPOSED AREA	1605.70 101.87	
15	TOTAL PROPOSED	1706.65 SQ.MT	

STAMP OF APPROVAL

Occupation is hereby granted
Subject to Conditions mentioned
in this Office letter
No. TMC/CPD-09/17/17
Date: 27/11/2021
V.P. No. 361/0006/17
The Municipal Corporation
The City of Thane
Deputy Engineer (TDD)
Executive Engineer (TDD)
Thane Municipal Corporation
The City of Thane

A) AREA STATEMENT				SQ.M.
1. AREA OF PLOT	960.80			960.80
2. DEDUCTIONS FOR				
(a) ROAD SET-BACK (RWS)	1466.72			1466.72
(b) PROPOSED ROAD (DR)	0.00			0.00
(c) ANY RESERVATION	0.00			0.00
(d) ENCROACHMENT AREA	86.16			86.16
(e) NDZ AREA	000.00			000.00
TOTAL (a+b+c+d+e)	249.88			249.88
3. BALANCE AREA OF PLOT (1-2)	710.92			710.92
4. DEDUCTIONS FOR				
(a) AMENITY SPACE (IF DEDUCTABLE)	0.00			0.00
(b) RECREATIONAL GROUND (IF DEDUCTABLE)	0.00			0.00
PHYSICAL RG PROVIDED =	000.00			000.00
5. NET BALANCE PLOT AREA OF PLOT (3-4)	710.92			710.92
6. ADDITION FOR F.S.I.				
(a) ROAD SET-BACK (RWS)	000.00			000.00
(b) PROPOSED ROAD (DR)	0.00			0.00
(c) AMENITY SPACE	0.00			0.00
(d) OTHER (CRZ II Area, Reserv Area ETC.)	0.00			0.00
TOTAL (a+b+c+d)	92.21			92.21
7. NET PLOT AREA (5+6)	803.13			803.13
8. FLOOR SPACE INDEX PERMISSIBLE	2.0000			2.0000
PERM. FLOOR AREA (7 X 8)	1606.27			1606.27
9. TDR AREA	0.00			0.00
10. SPECIAL CASES FSI	519.71			519.71
11. TOTAL PERM. BUILT UP AREA (8+9+10)	2125.98			2125.98
12. PROPOSED AREAS				
(a) PROPOSED RESIDENTIAL AREA	1604.78			1604.78
(b) PROPOSED COMMERCIAL AREA	101.87			101.87
(c) PROPOSED INDUSTRIAL AREA	0.00			0.00
(d) PROPOSED SPECIAL USE AREA	0.00			0.00
TOTAL PROPOSED AREA (a+b+c+d)	1706.65			1706.65
13. SUB STRUCTURE AREA ADDITION (FOR FSI)	0.00			0.00
14. SUB STRUCTURE AREA DEDUCTION (FOR FSI)	0.00			0.00
15. EXCESS BALCONY AREA TAKEN IN F.S.I.	0.00			0.00
16. EXISTING BUILT UP AREA	0.00			0.00
17. SURRENDERED AREA	000.00			000.00
18. TOTAL PROPOSED B/UP AREA	1706.65			1706.65
19. CONSUMED FSI	0.60			0.60
B) BALCONY STATEMENT				
(i) PERMISSIBLE BALCONY AREA	160.48			160.48
(ii) PROPOSED BALCONY AREA	154.67			154.67
(iii) EXCESS BALCONY AREA (TOTAL)	0.00			0.00
C) TENEMENT STATEMENT				
(i) PROPOSED AREA (12)	1706.65			1706.65
(ii) LESS NON RESIDENTIAL AREA	101.87			101.87
(iii) AREA AVAILABLE FOR TENEMENTS (i - ii)	1604.78			1604.78
(iv) TENEMENTS PERMISSIBLE	NA	NA		NA
(v) TENEMENTS PROPOSED	42			42
(vi) TENEMENTS EXISTING	0			0
(vii) TOTAL TENEMENTS ON THE PLOT (v+vi)	42			42
D) PARKING STATEMENT				
	CARS	2 WHEELERS	VISITORS	
(i) PARKING REQUIRED BY RULE	24	38	2	2
(ii) PARKING PROVIDED	20	48	20.70	20.70
(v) TOTAL PARKING PROVIDED	268.20	61.20	00	00
(a) TRANSPORT VEHICLES PARKING PROVIDED				0
(b) LOADING / UNLOADING PARKING PROVIDED				-NA-
(c) AMBULANCE PARKING PROVIDED				0
SPECIFICATIONS				

CERTIFICATE OF AREA

CERTIFIED THAT I HAVE SURVEYED THE PLOT UNDER REFERENCE ON AND THAT THE DIMENSIONS OF THE SIDES, ETC. OF THE PLOT STATED ON THE PLAN ARE AS MEASURED ON THE SITE AND THE AREA SO WORKED OUT IS SQUARE METRES AND TALLIES WITH THE AREA STATED IN THE DOCUMENT OF OWNERSHIP / TOWN PLANNING SCHEME RECORDS.

LEGEND
PLOT BOUNDARY SHOWN THICK BLACK
PROPOSED WORK SHOWN RED FILLED IN
DRAINAGE LINE SHOWN RED DOTTED
WATERLINE SHOWN BLUE DOTTED
EXISTING TO BE RETAINED HATCHED
DEMOLITION SHOWN HATCHED YELLOW

OWNER'S NAME / DEVELOPER NAME / POA HOLDER: M/S. SACHIN ENTERPRISES
OWNER ADDRESS: OFFICE NO.1, HORIZON HEIGHTS COMMERCIAL, 2 ND FLOOR, KASARVADEVALI, THANE


PROJECT:
Plot No. / F. Plot No. :
Survey No. :
CTS No : 128,129A
Tika No :
Gut No :
Village : OVALA

ARCHITECT: ARCHITECT NAME: Prashant Arunkumar Thakkar
ARCHITECT ADDRESS: 401/4th Floor, Nitin Villa Behind Gurukul Society



JOB NO. DRG.NO. SCALE DRAWN BY CHECKED BY
1:100
INWARD NO. S80/0008/17 DATE 04-06-2021
KEY NO. SHEET NO. 1/3

O.C FOR 1st Floor (pt) + Ground (pt) + 1st Floor & 2nd Floor

Crementing part only.

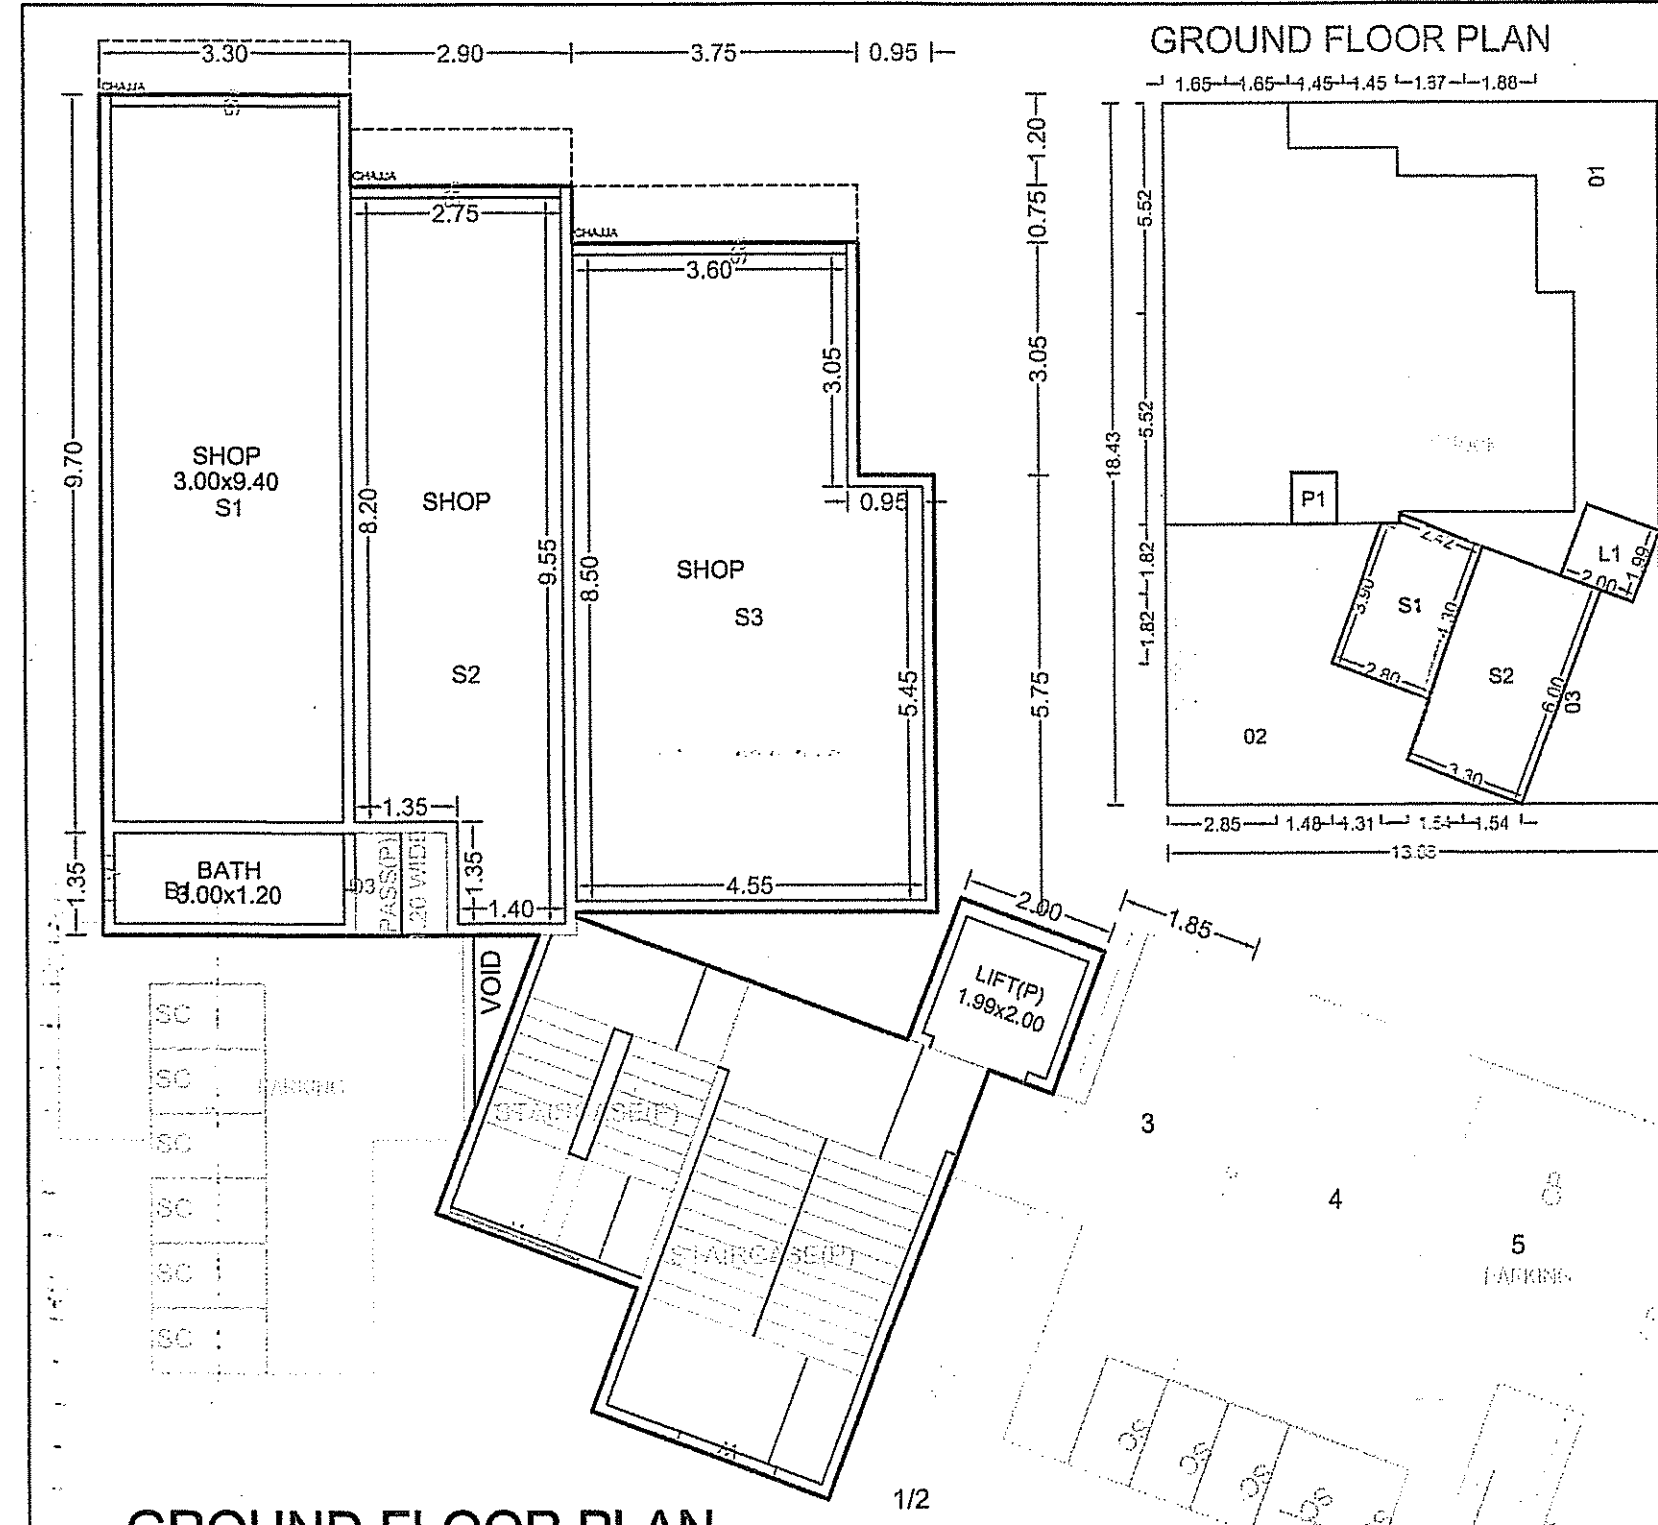

Polygon	Area
A-Block	241.15
01	43.56
02	43.63
03	14.80
L1	3.97
P1	1.62
S1	11.90
S2	19.80
Total	101.67

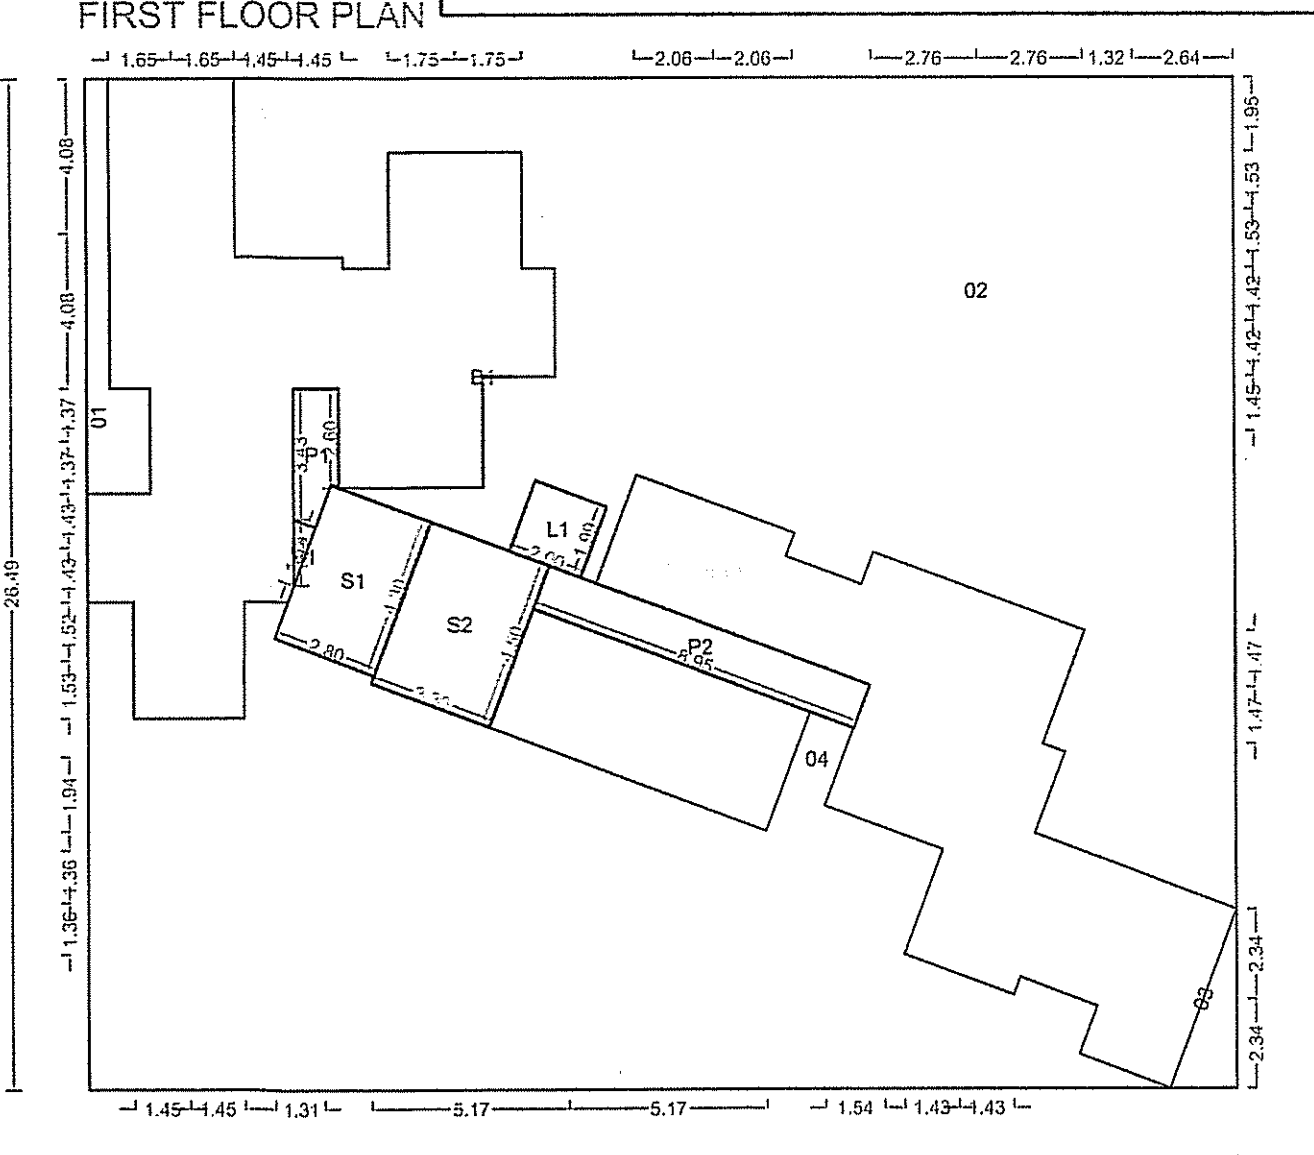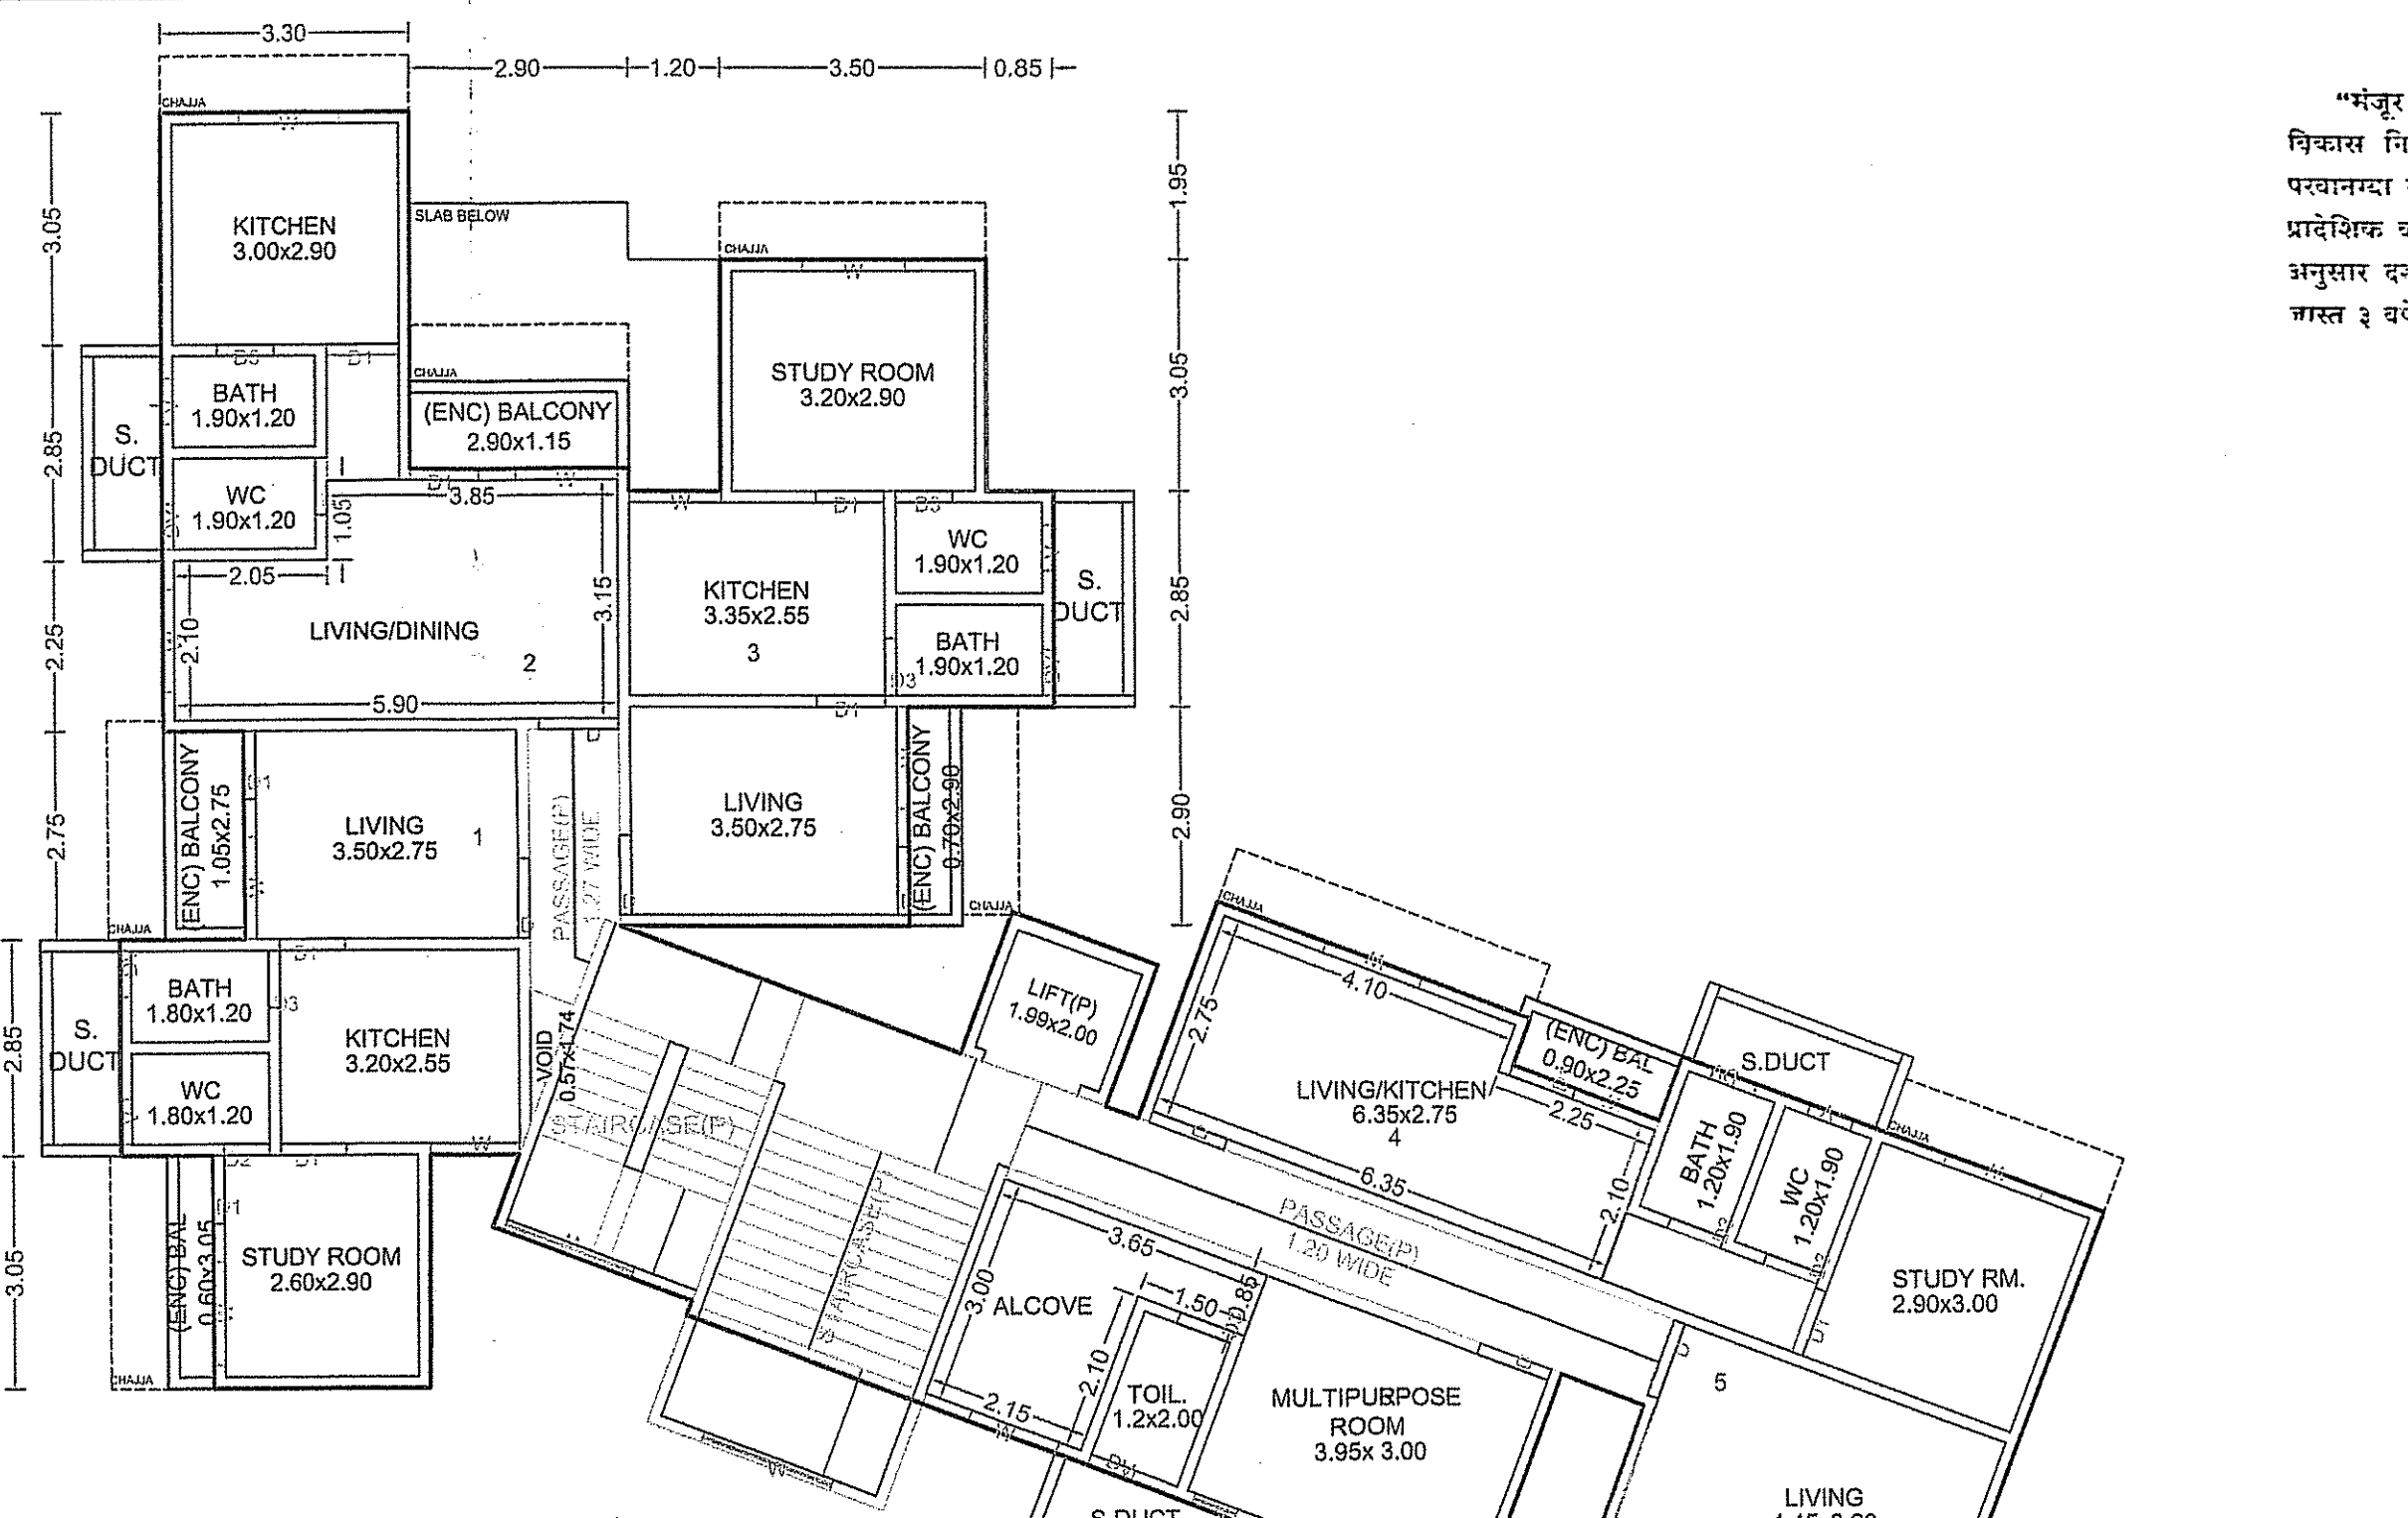

STAMP OF APPROVAL

Occupation is hereby granted Subject to Conditions mentioned in this Office Letter No. TMC/CD-20/175 Date: 27/10/2022



Deputy Engineer (TDD) Thane Municipal Corporation The City of Thane

Executive Engineer (TDD)

BUILDING: BUILDING (1)

GROUND FLOOR PLAN

FIRST FLOOR PLAN

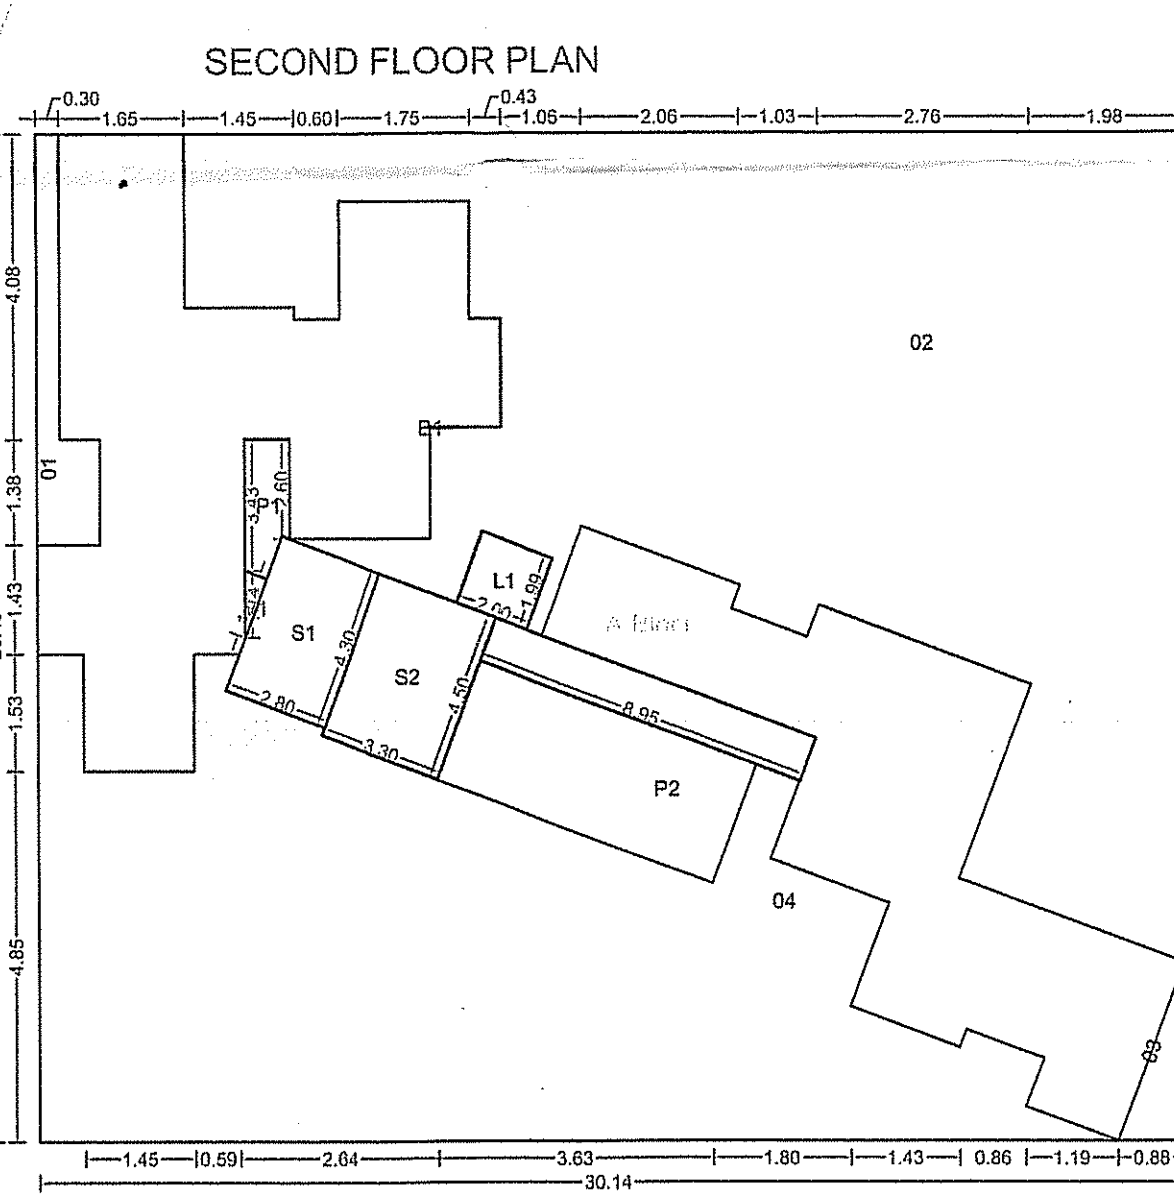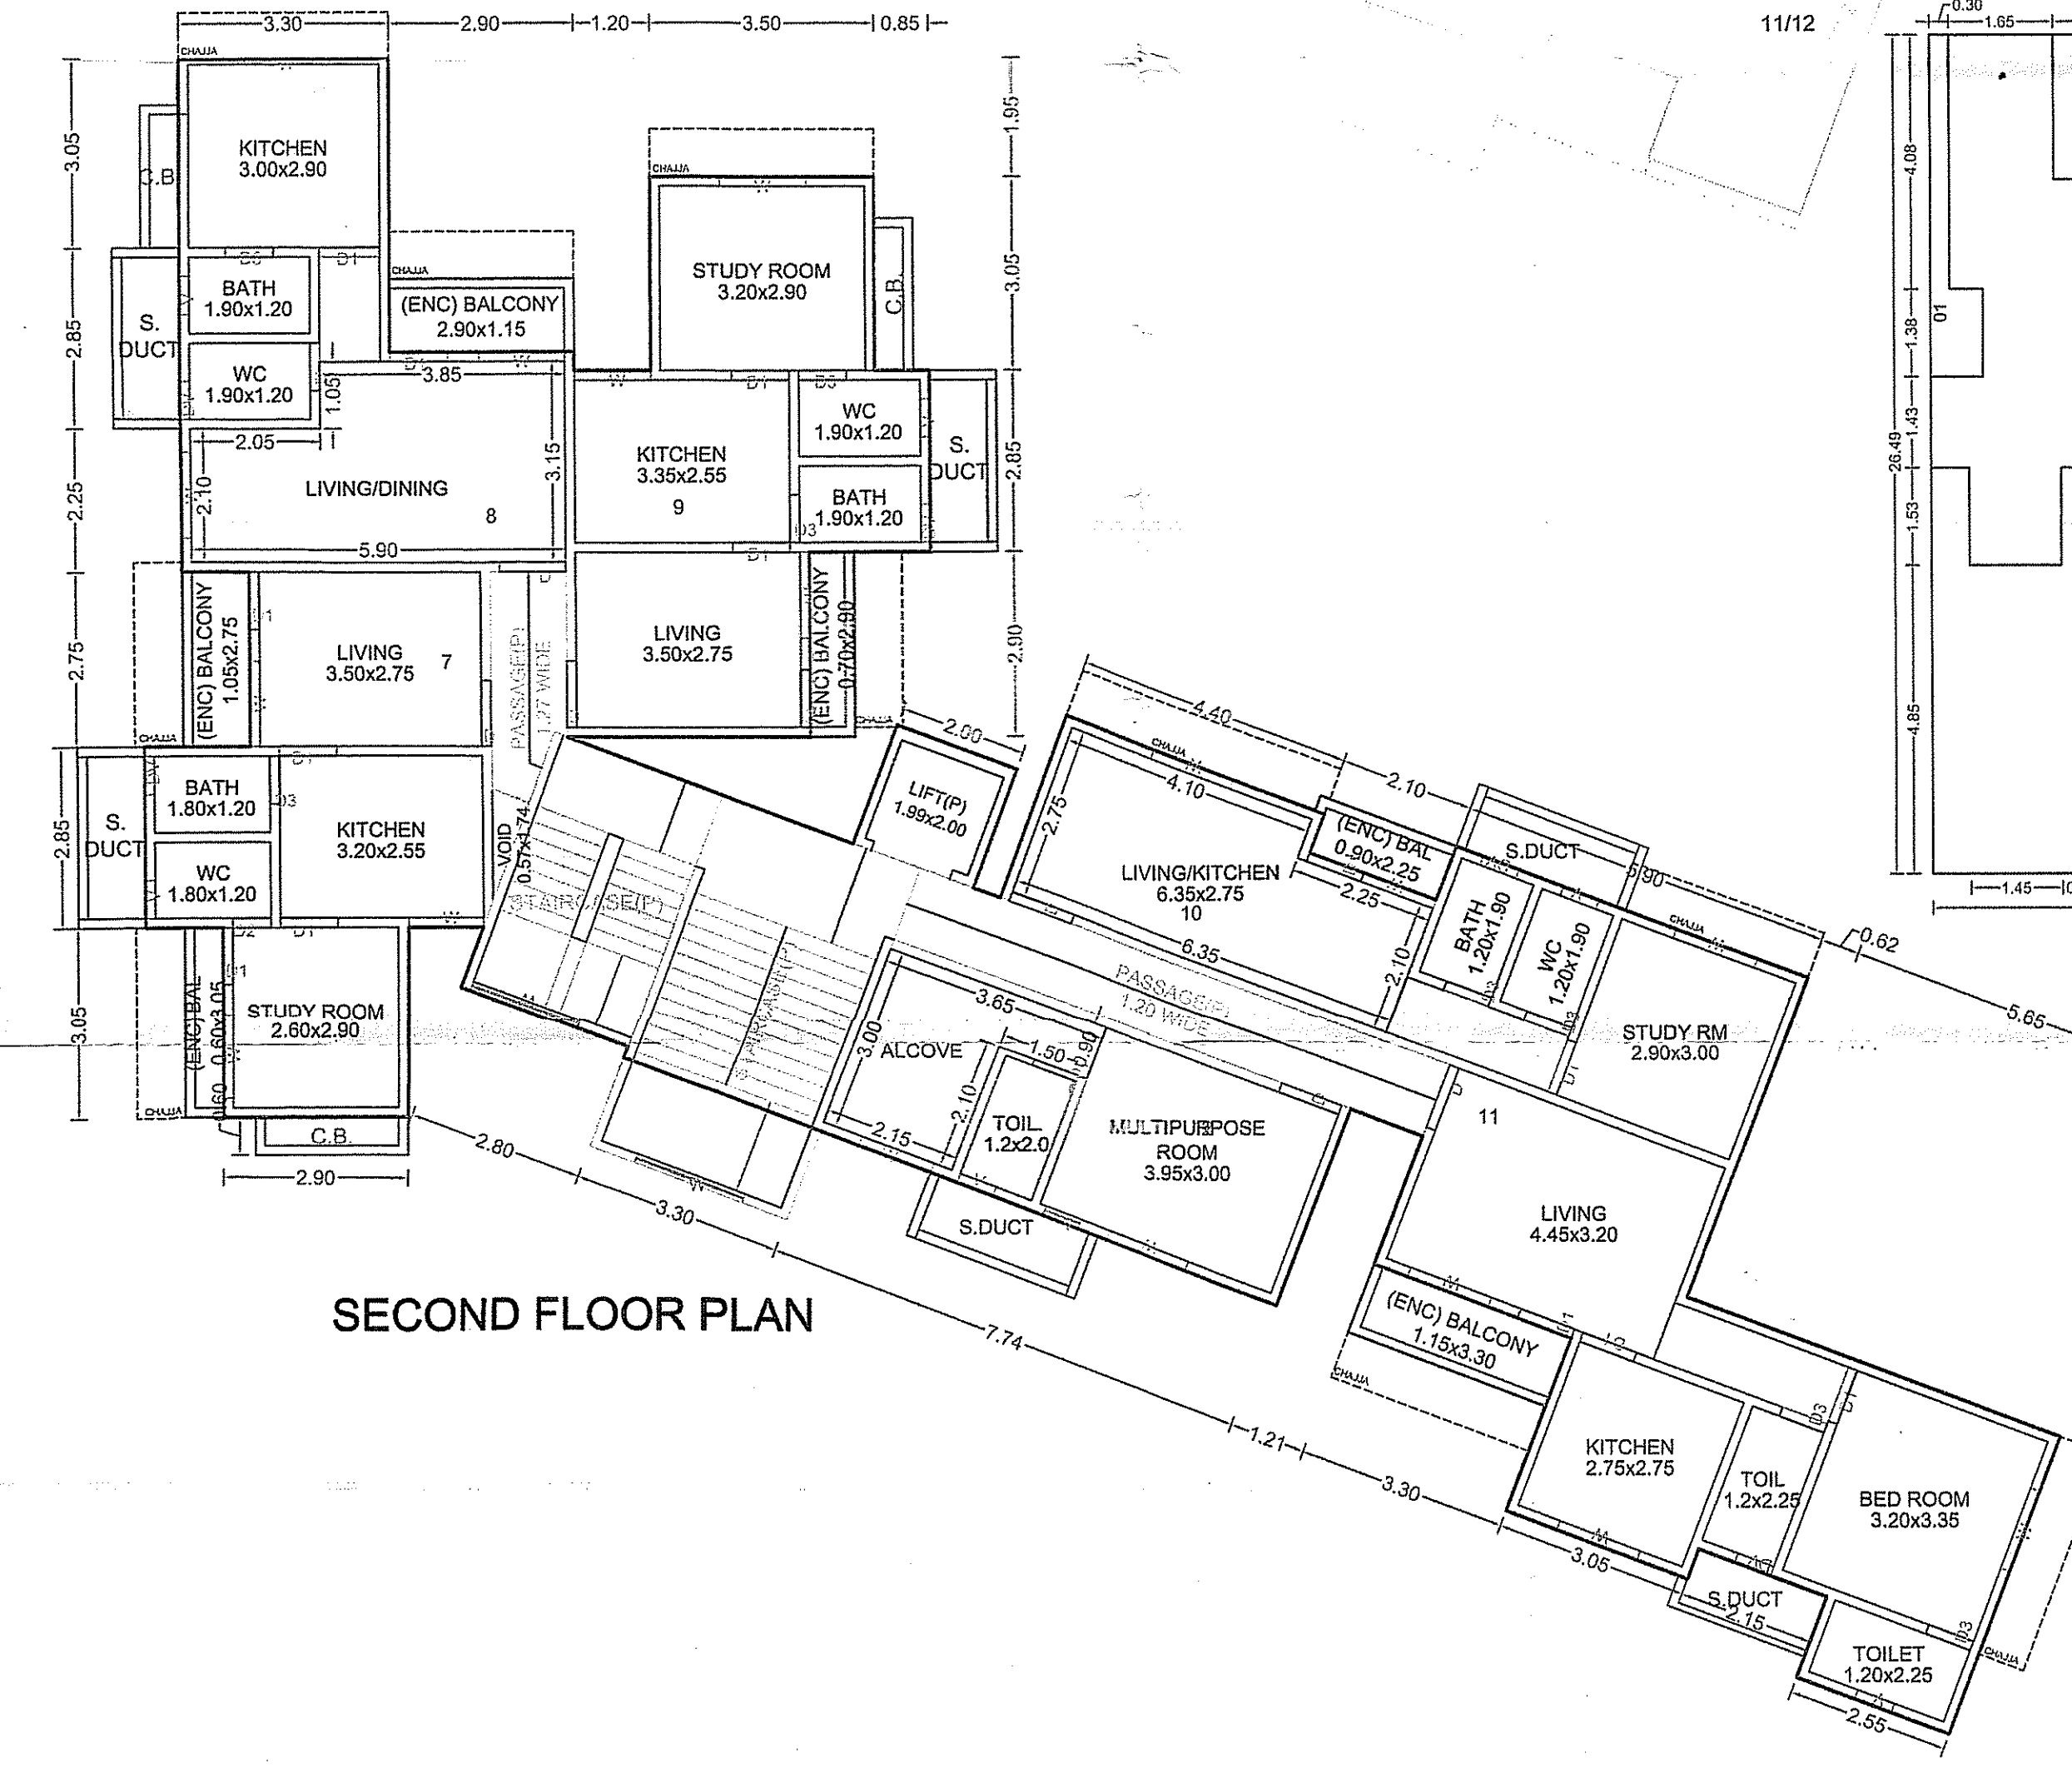

AS BUILT PLAN

Polygon	Area
A-Block	798.45
01	9.43
02	301.46
03	4.11
04	217.40
L1	3.97
V1	0.50
P1	3.86
P2	10.74
S1	12.04
S2	14.85
B1	0.00
Total	220.49

SANCTIONED

Polygon	Area
A-Block	798.45
01	9.43
02	300.07
03	4.11
04	217.40
L1	3.97
V1	0.50
P1	3.86
P2	10.74
S1	12.04
S2	14.85
B1	0.00
Total	221.80

AS BUILT PLAN

Polygon	Area
A-Block	798.45
01	9.43
02	301.46
03	4.11
04	217.40
L1	3.97
V1	0.50
P1	3.86
P2	10.74
S1	12.04
S2	14.85
B1	0.00
Total	220.09

SANCTIONED

Polygon	Area
A-Block	798.45
01	9.43
02	300.07
03	4.11
04	217.40
L1	3.97
V1	0.50
P1	3.86
P2	10.74
S1	12.04
S2	14.85
B1	0.00
Total	221.80

BALCONY CALCULATIONS: BUILDING (1)

FLOOR	SIZE	AREA	TOT. AREA
SEVENTH FLOOR	1.15 X 2.90 X 1	3.34	23.10
	1.05 X 2.75 X 1	2.89	
	0.60 X 3.05 X 1	1.83	
	0.90 X 2.25 X 1	1.93	
	0.70 X 2.90 X 1	2.03	
	1.15 X 3.30 X 1	3.80	
	1.50 X 3.05 X 1	4.58	
	1.20 X 2.25 X 1	2.70	
SIXTH FLOOR	1.15 X 2.90 X 1	3.34	23.10
	1.05 X 2.75 X 1	2.89	
	0.60 X 3.05 X 1	1.83	
	0.90 X 2.25 X 1	1.93	
	0.70 X 2.90 X 1	2.03	
	1.15 X 3.30 X 1	3.80	
	1.50 X 3.05 X 1	4.58	
	1.20 X 2.25 X 1	2.70	
FIFTH FLOOR	1.15 X 2.90 X 1	3.34	23.10
	1.05 X 2.75 X 1	2.89	

	0.60 X 3.05 X 1	1.83	
	0.90 X 2.25 X 1	1.93	
	0.70 X 2.90 X 1	2.03	
	1.15 X 3.30 X 1	3.80	
	1.50 X 3.05 X 1	4.58	
	1.20 X 2.25 X 1	2.70	
FOURTH FLOOR	1.15 X 2.90 X 1	3.34	23.10
	1.05 X 2.75 X 1	2.89	
	0.60 X 3.05 X 1	1.83	
	0.90 X 2.25 X 1	1.93	
	0.70 X 2.90 X 1	2.03	
	1.15 X 3.30 X 1	3.80	
	1.50 X 3.05 X 1	4.58	
	1.20 X 2.25 X 1	2.70	
THIRD FLOOR	1.15 X 2.90 X 1	3.34	23.10
	1.05 X 2.75 X 1	2.89	
	0.60 X 3.05 X 1	1.83	
	0.90 X 2.25 X 1	1.93	
	0.70 X 2.90 X 1	2.03	

	1.15 X 3.30 X 1	3.80	
	1.50 X 3.05 X 1	4.58	
	1.20 X 2.25 X 1	2.70	
SECOND FLOOR	1.15 X 2.90 X 1	3.34	19.66
	1.05 X 2.75 X 1	2.89	
	0.60 X 3.05 X 1	1.83	
	0.90 X 2.25 X 1	1.93	
	0.70 X 2.90 X 1	2.03	
	1.15 X 3.30 X 1	3.80	
	1.20 X 3.20 X 1	3.84	
FIRST FLOOR	1.15 X 2.90 X 1	3.34	19.66
	1.05 X 2.75 X 1	2.89	
	0.60 X 3.05 X 1	1.83	
	0.90 X 2.25 X 1	1.93	
	0.70 X 2.90 X 1	2.03	
	1.15 X 3.30 X 1	3.80	
	1.20 X 3.20 X 1	3.84	
Total	-	-	154.67

OWNER'S NAME / DEVELOPER NAME / POA HOLDER: M/S. SACHIN ENTERPRISES

OWNER ADDRESS: OFFICE NO.1, HORIZON HEIGHTS COMMERCIAL 2 ND FLOOR, KASARVADAVALI, THANE


PROJECT: Plot No. / F. Plot No. : CTS No : 128,129A Tika No : Gut No : Village : OVALA

ARCHITECT: M/S. SACHIN ENTERPRISES


ARCHITECT ADDRESS: 401/4th Floor, Nitin villa Behind Gurukul Society

KEY NO. : JOB NO. : DRG. NO. : SCALE : 1:100 DRAWN BY : CHECKED BY : DATE : 04-08-2021 SHEET NO. : 2 / 3

O.C. FOR:- Split (P) + Ground (P) + 1st Floor & 2nd Floor
(Remaining Part) only.

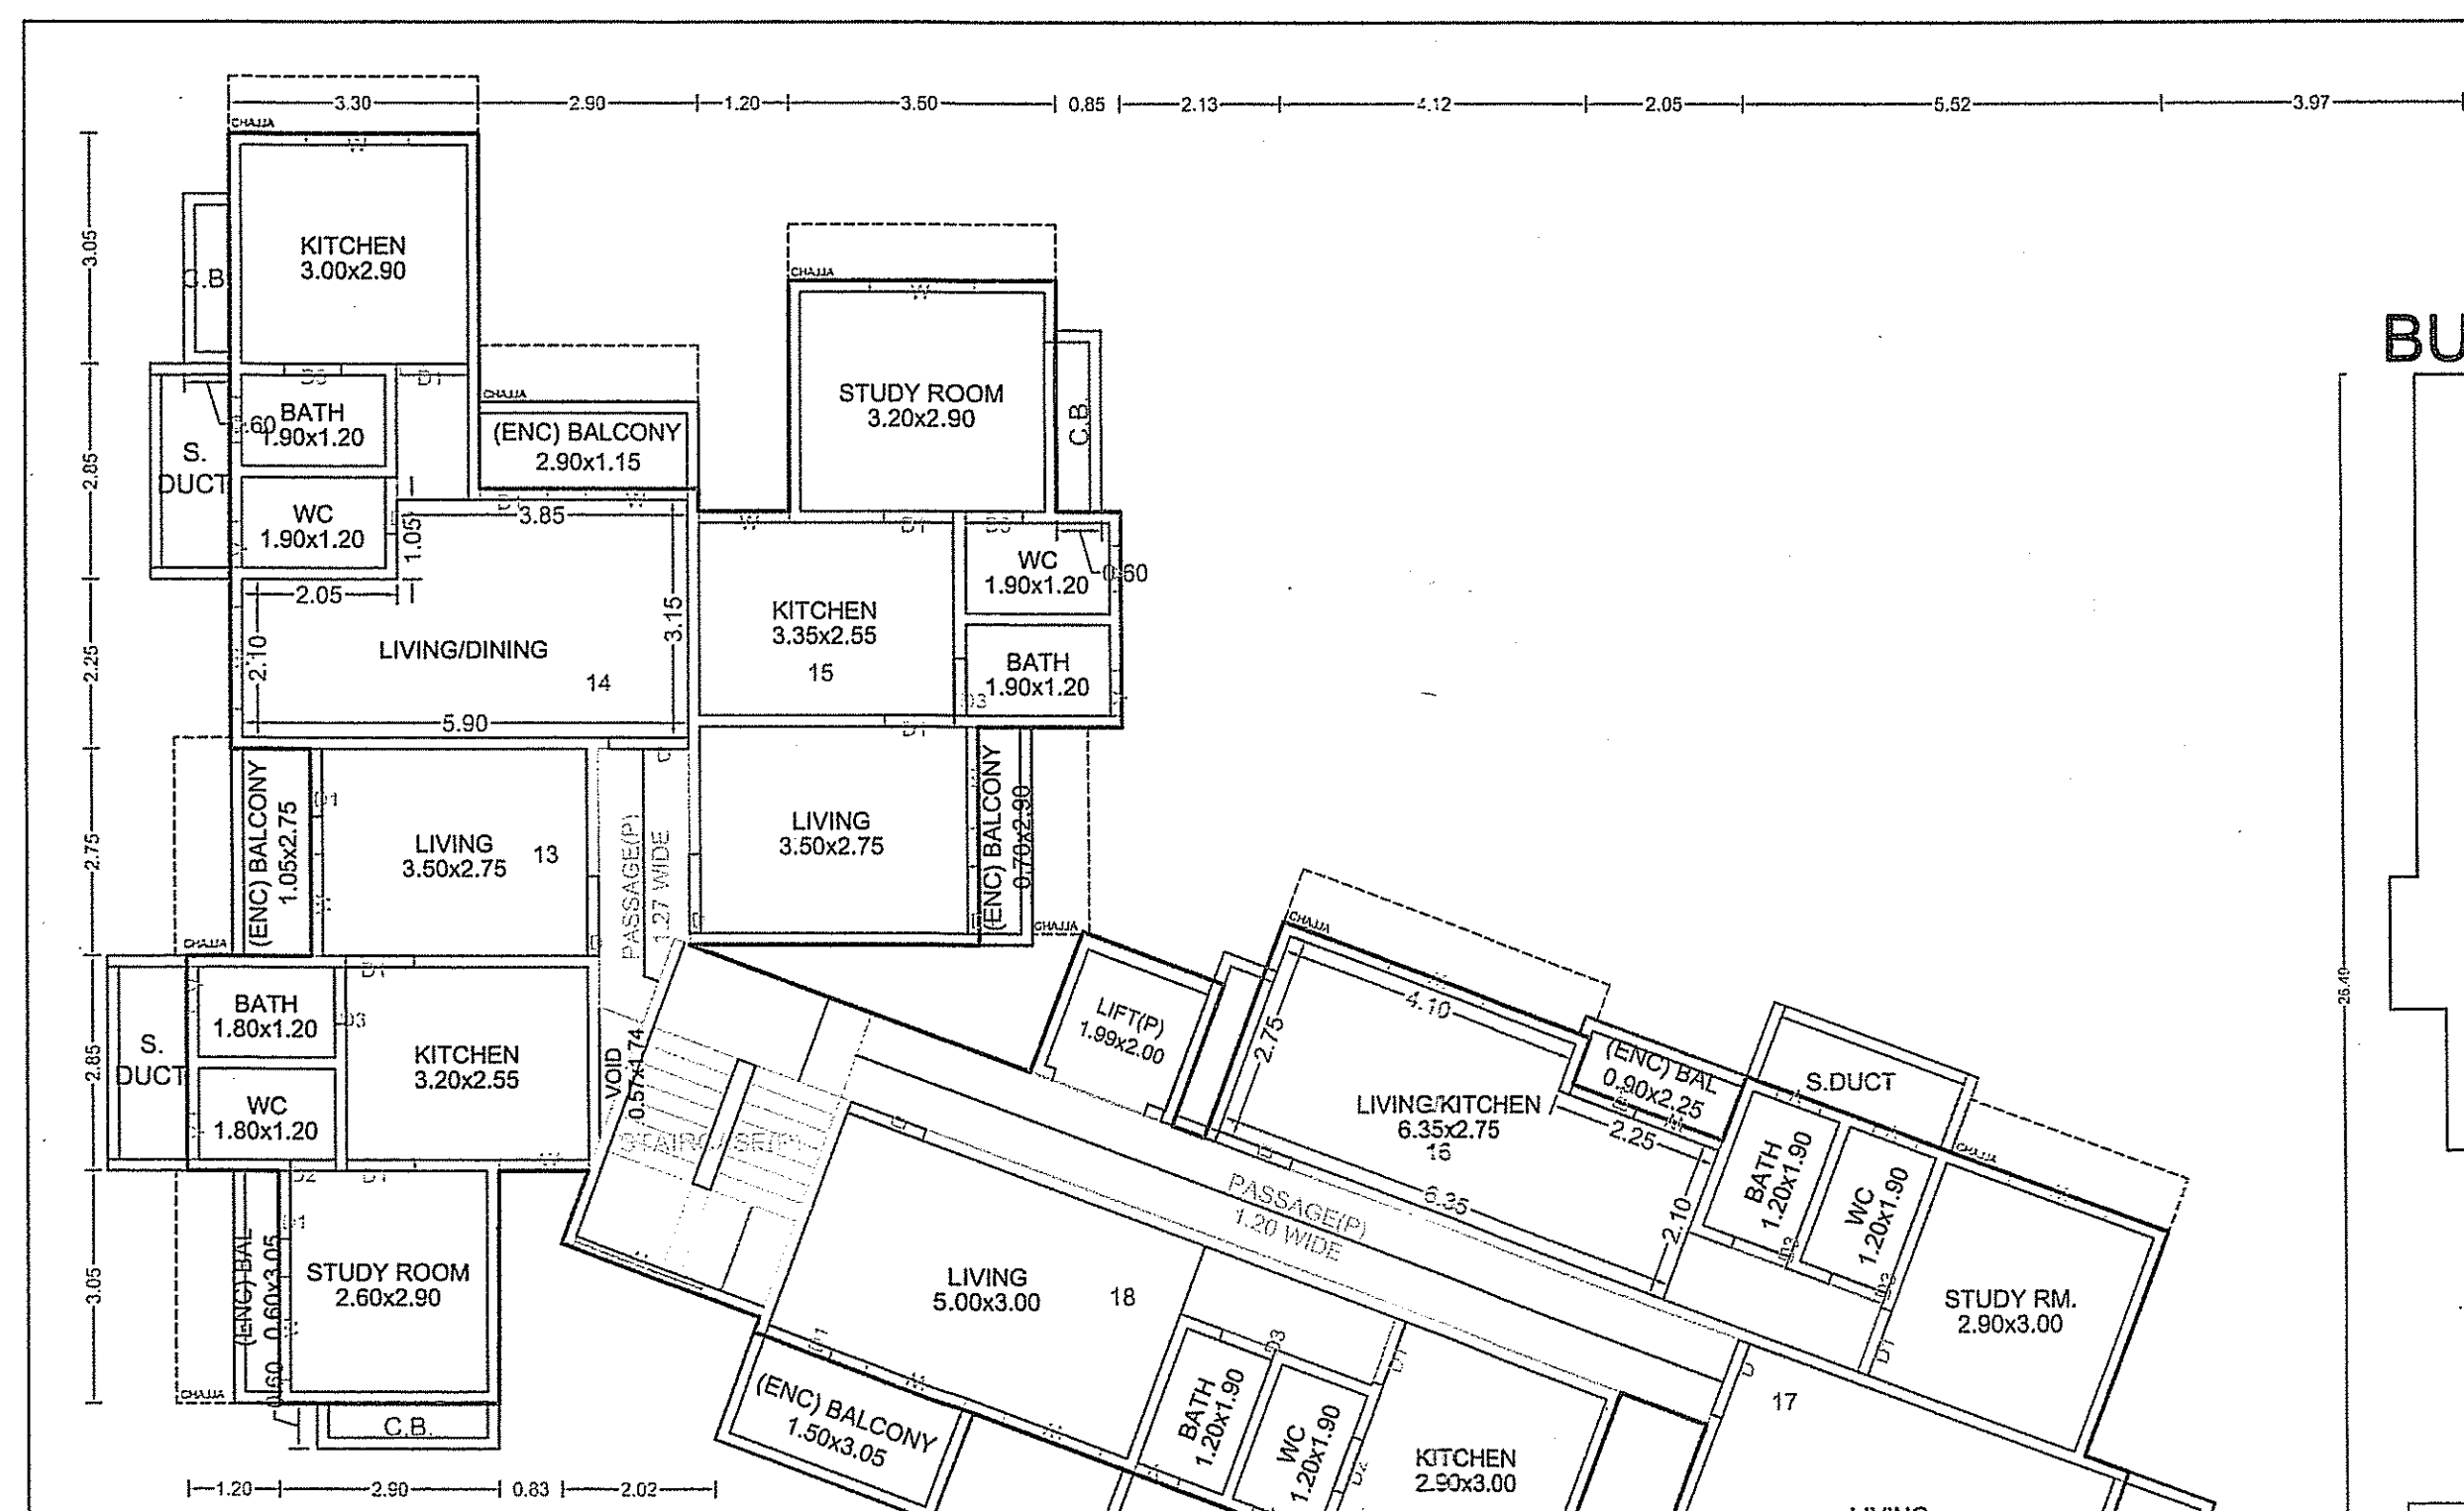


TYPICAL - 3- 7 FLOOR PLAN

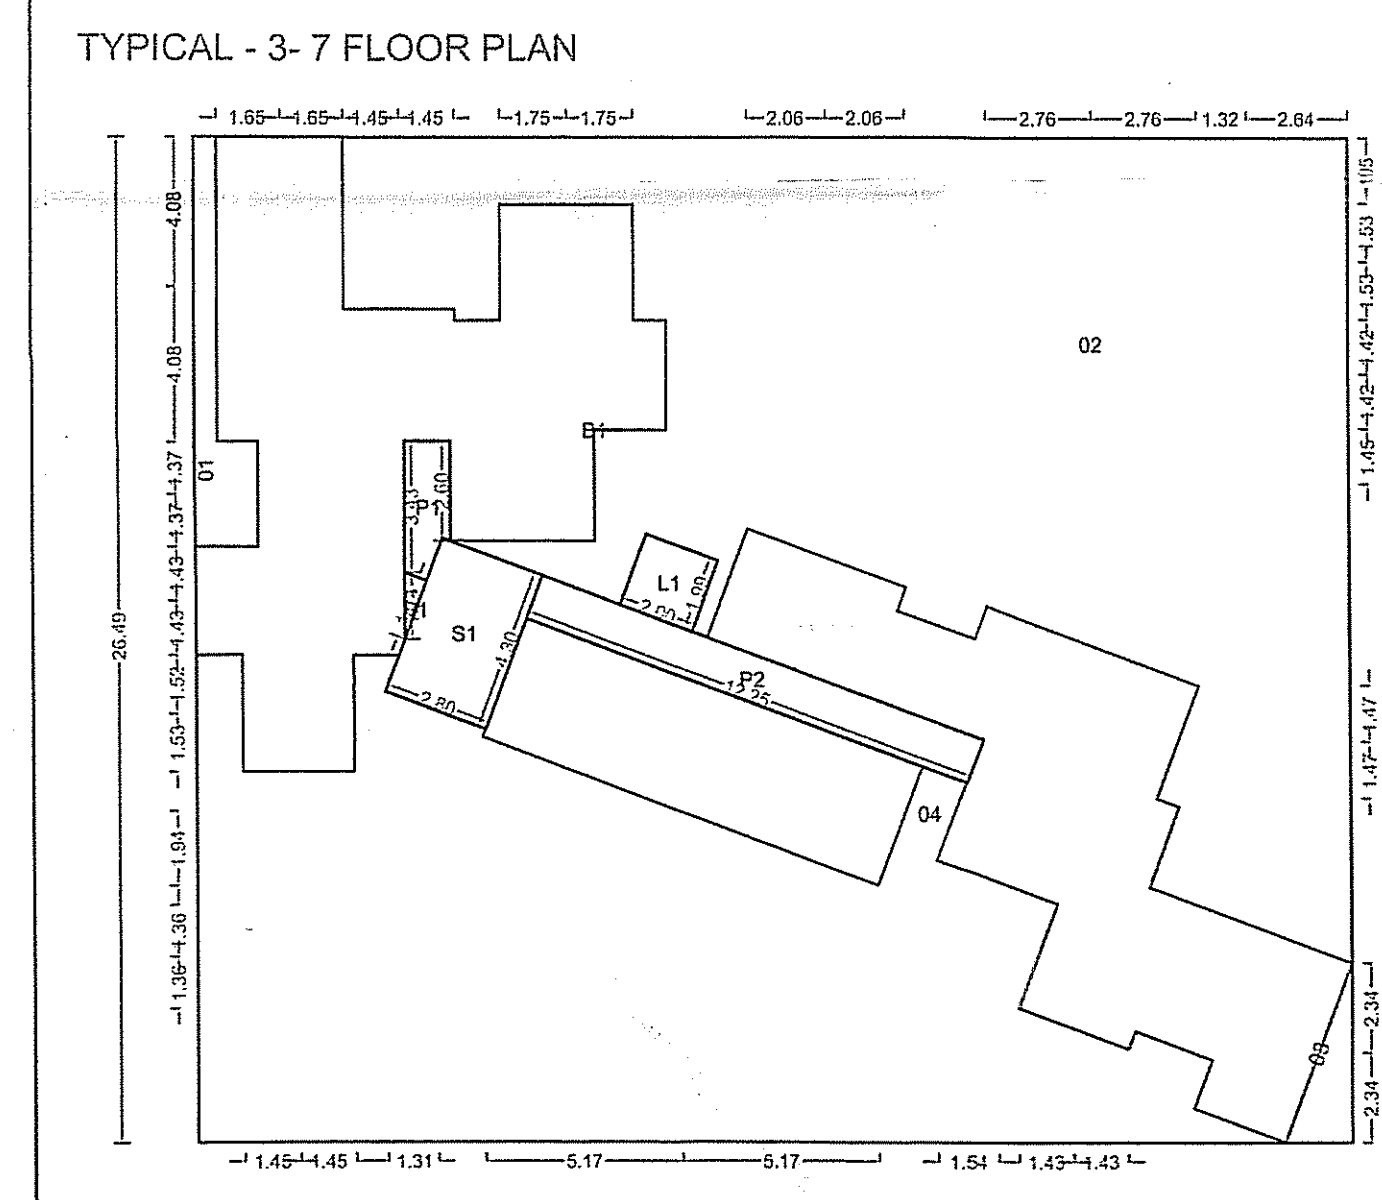


Polygon	Area
A-Block	798.45
O1	9.43
O2	300.07
O3	4.11
O4	217.40
L1	3.97
V1	0.50
P1	3.86
P2	14.70
S1	12.04
B1	0.00
Total	232.37

BUILDING (1)

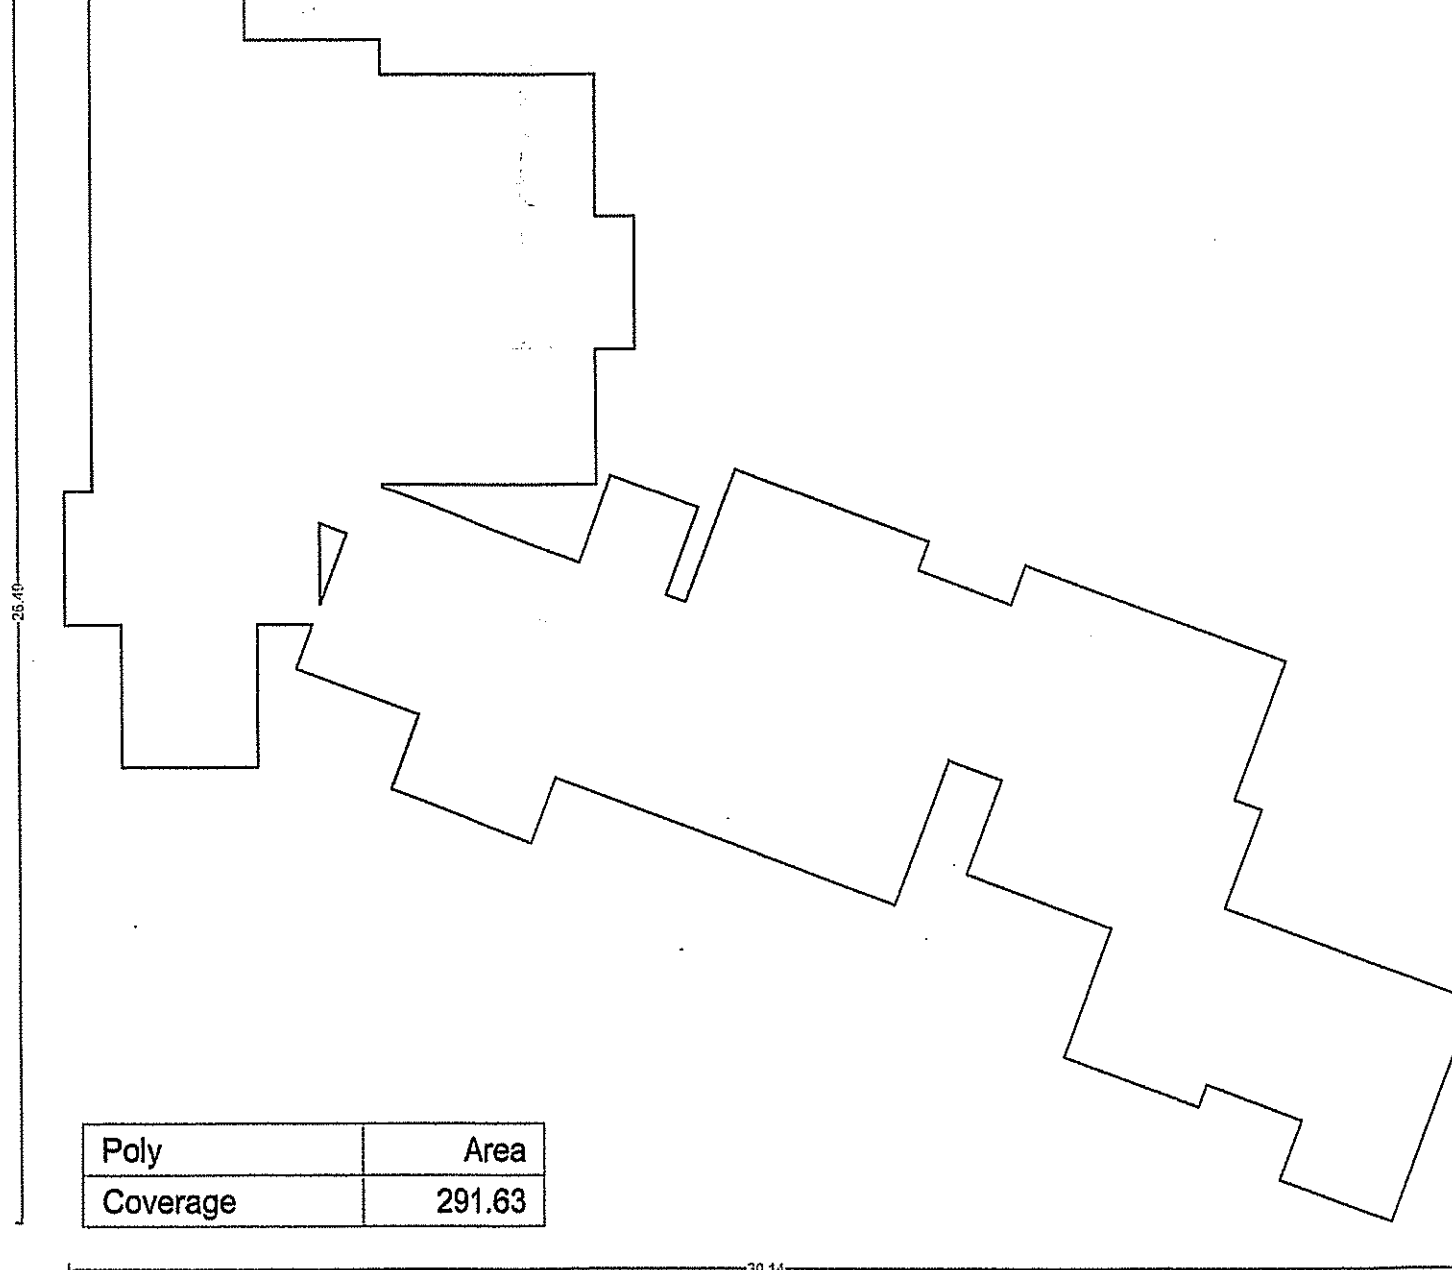

Poly	Area
Coverage	291.63

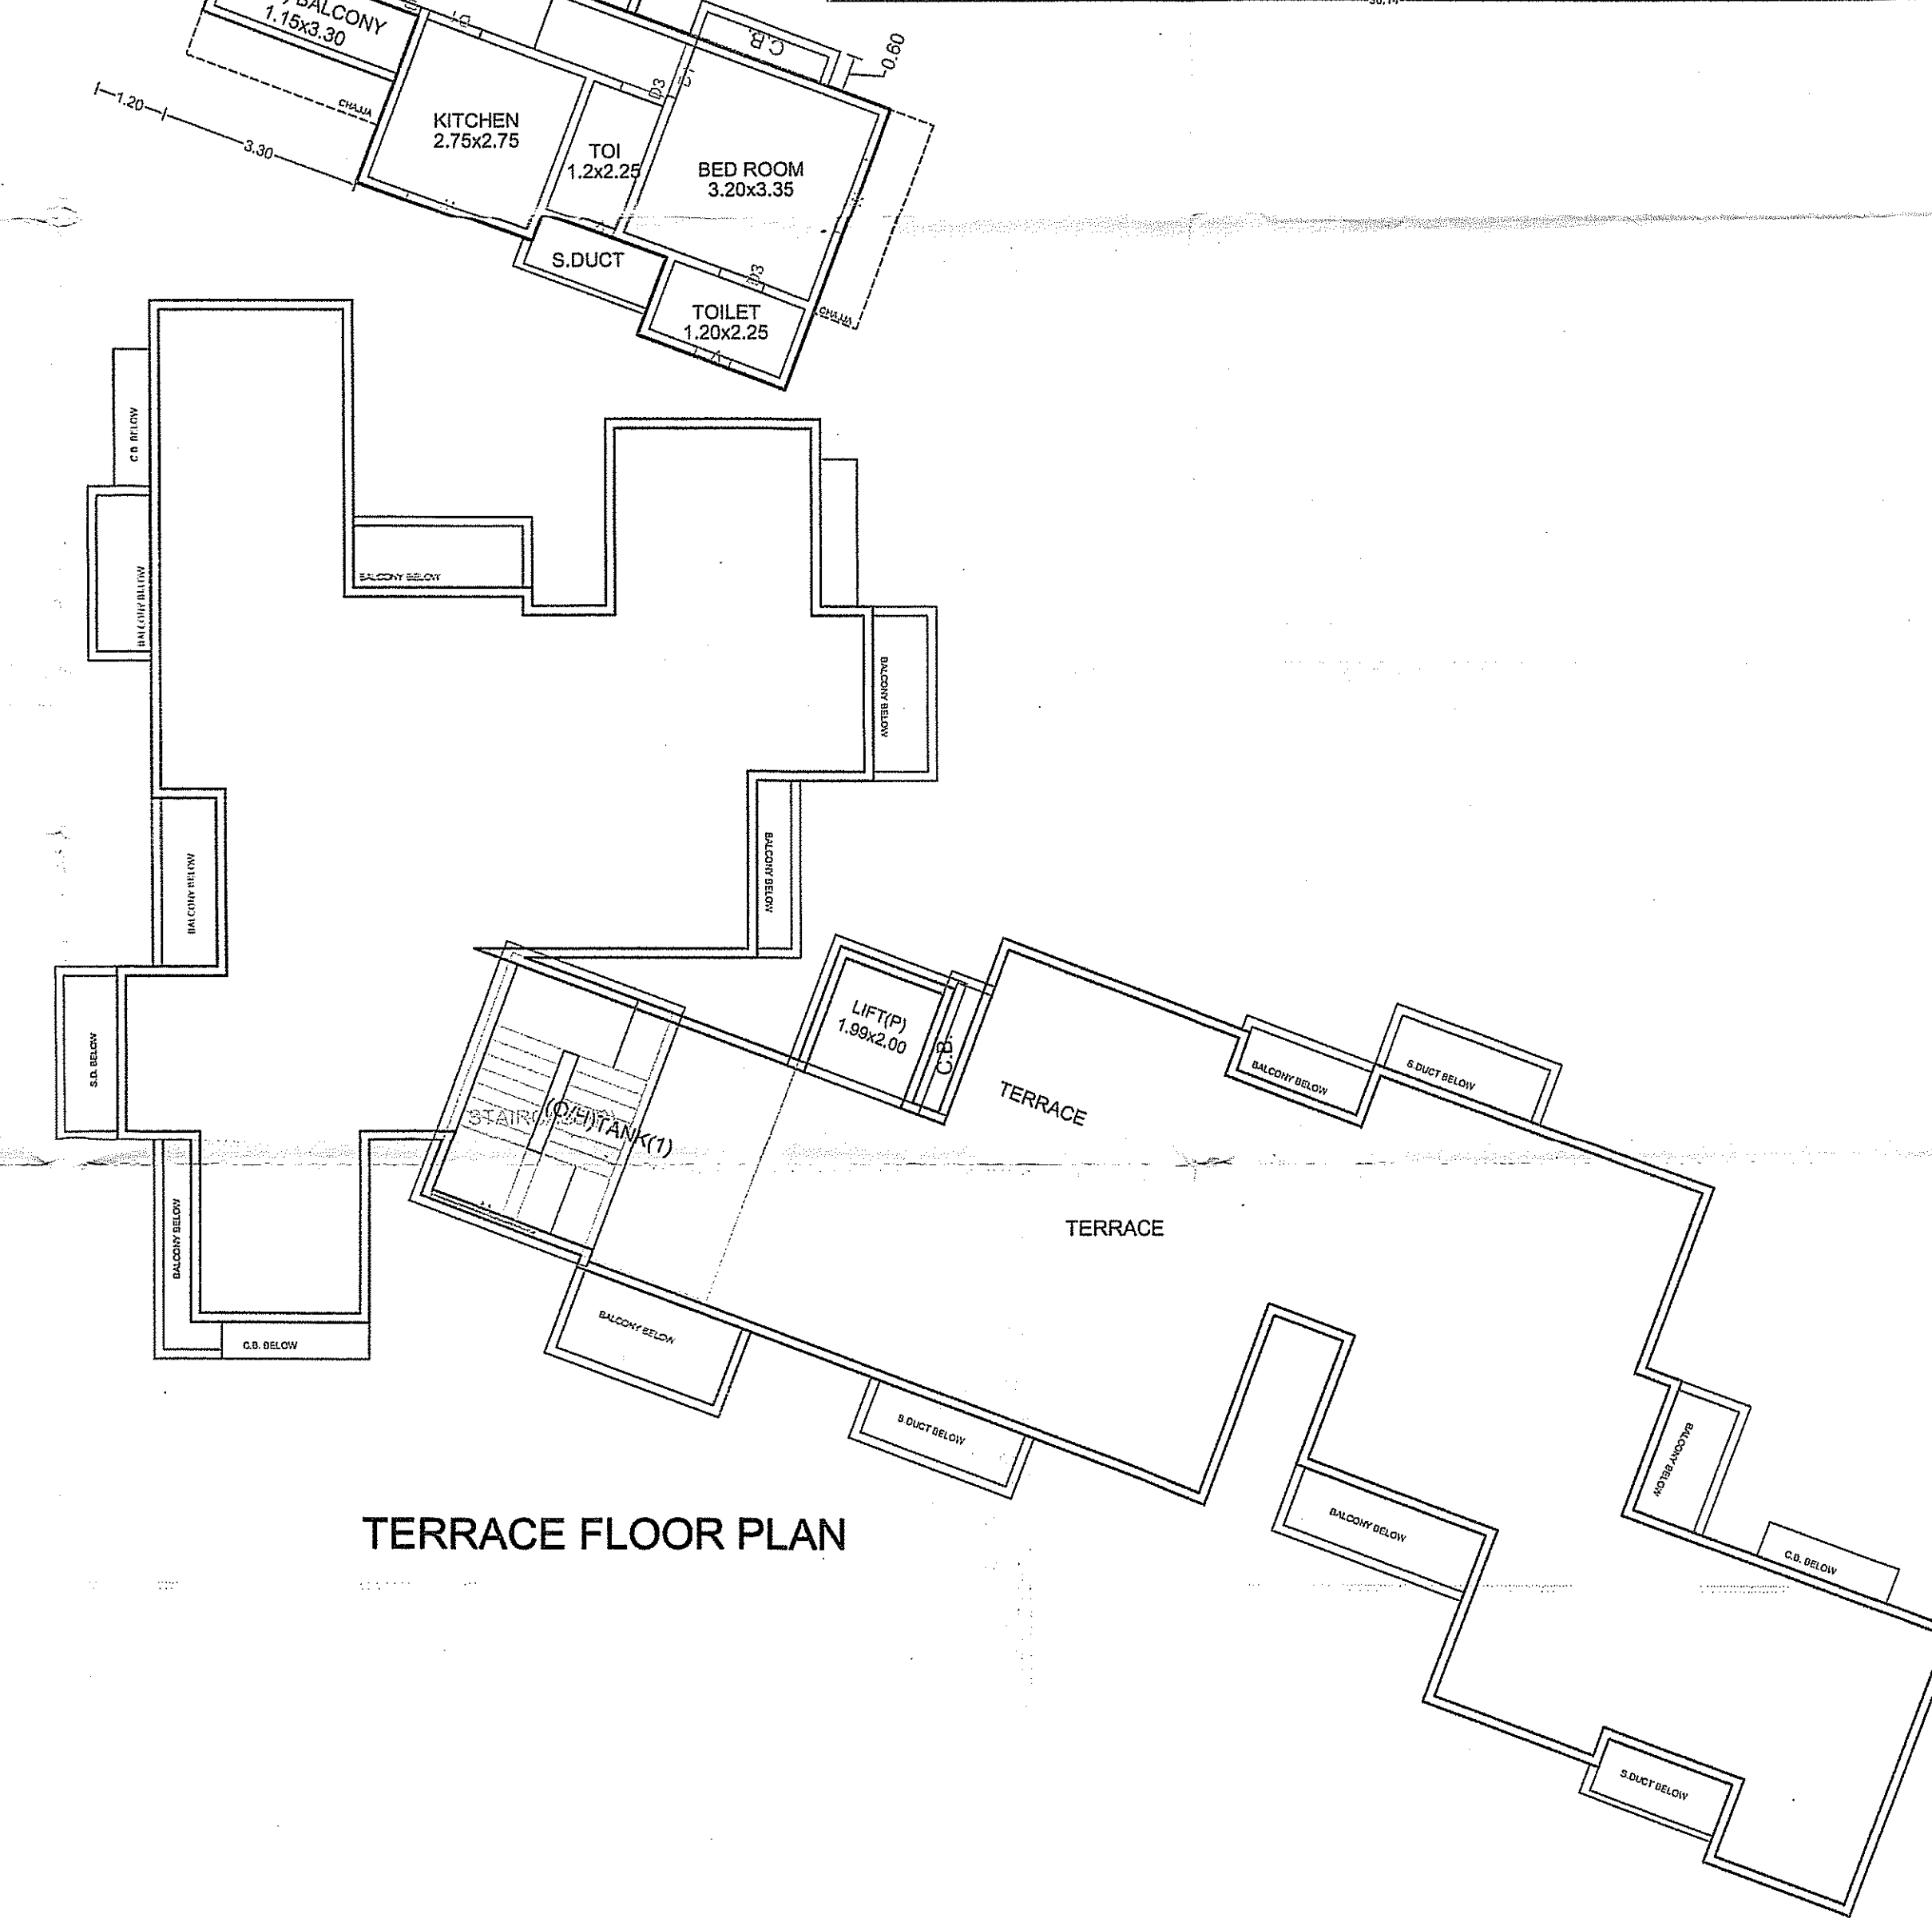

TERRACE FLOOR PLAN


संयोजक
"मंजूर नकशानुसार चोखसस न करणे तराच
विकास नियंत्रण विभागावलीनुसार आदेशक त्या
परवानग्या न घेता चोखसस धरप करणे, मर्याद
प्रादेशिक व नगर रचना अधिनियम-१९६२
अनुसार दखलनाम गुन्हा आहे. न्यायसल! जास्तीत
जास्त ३ वर्षे कैद व र. १०००/- दंड होऊ शकतो"

STAMP OF APPROVAL

Occupation is hereby granted
Subject to Conditions mentioned
in this Office Letter
No. TMC/ED-DP/TPS/06C/0965/21
V.P. No. 566/0006/17
Dated: 07/10/2021

Deputy Engineer (TDD)
Executive Engineer (TDD)
Thane Municipal Corporation
The City of Thane

BUILDING: BUILDING (1)

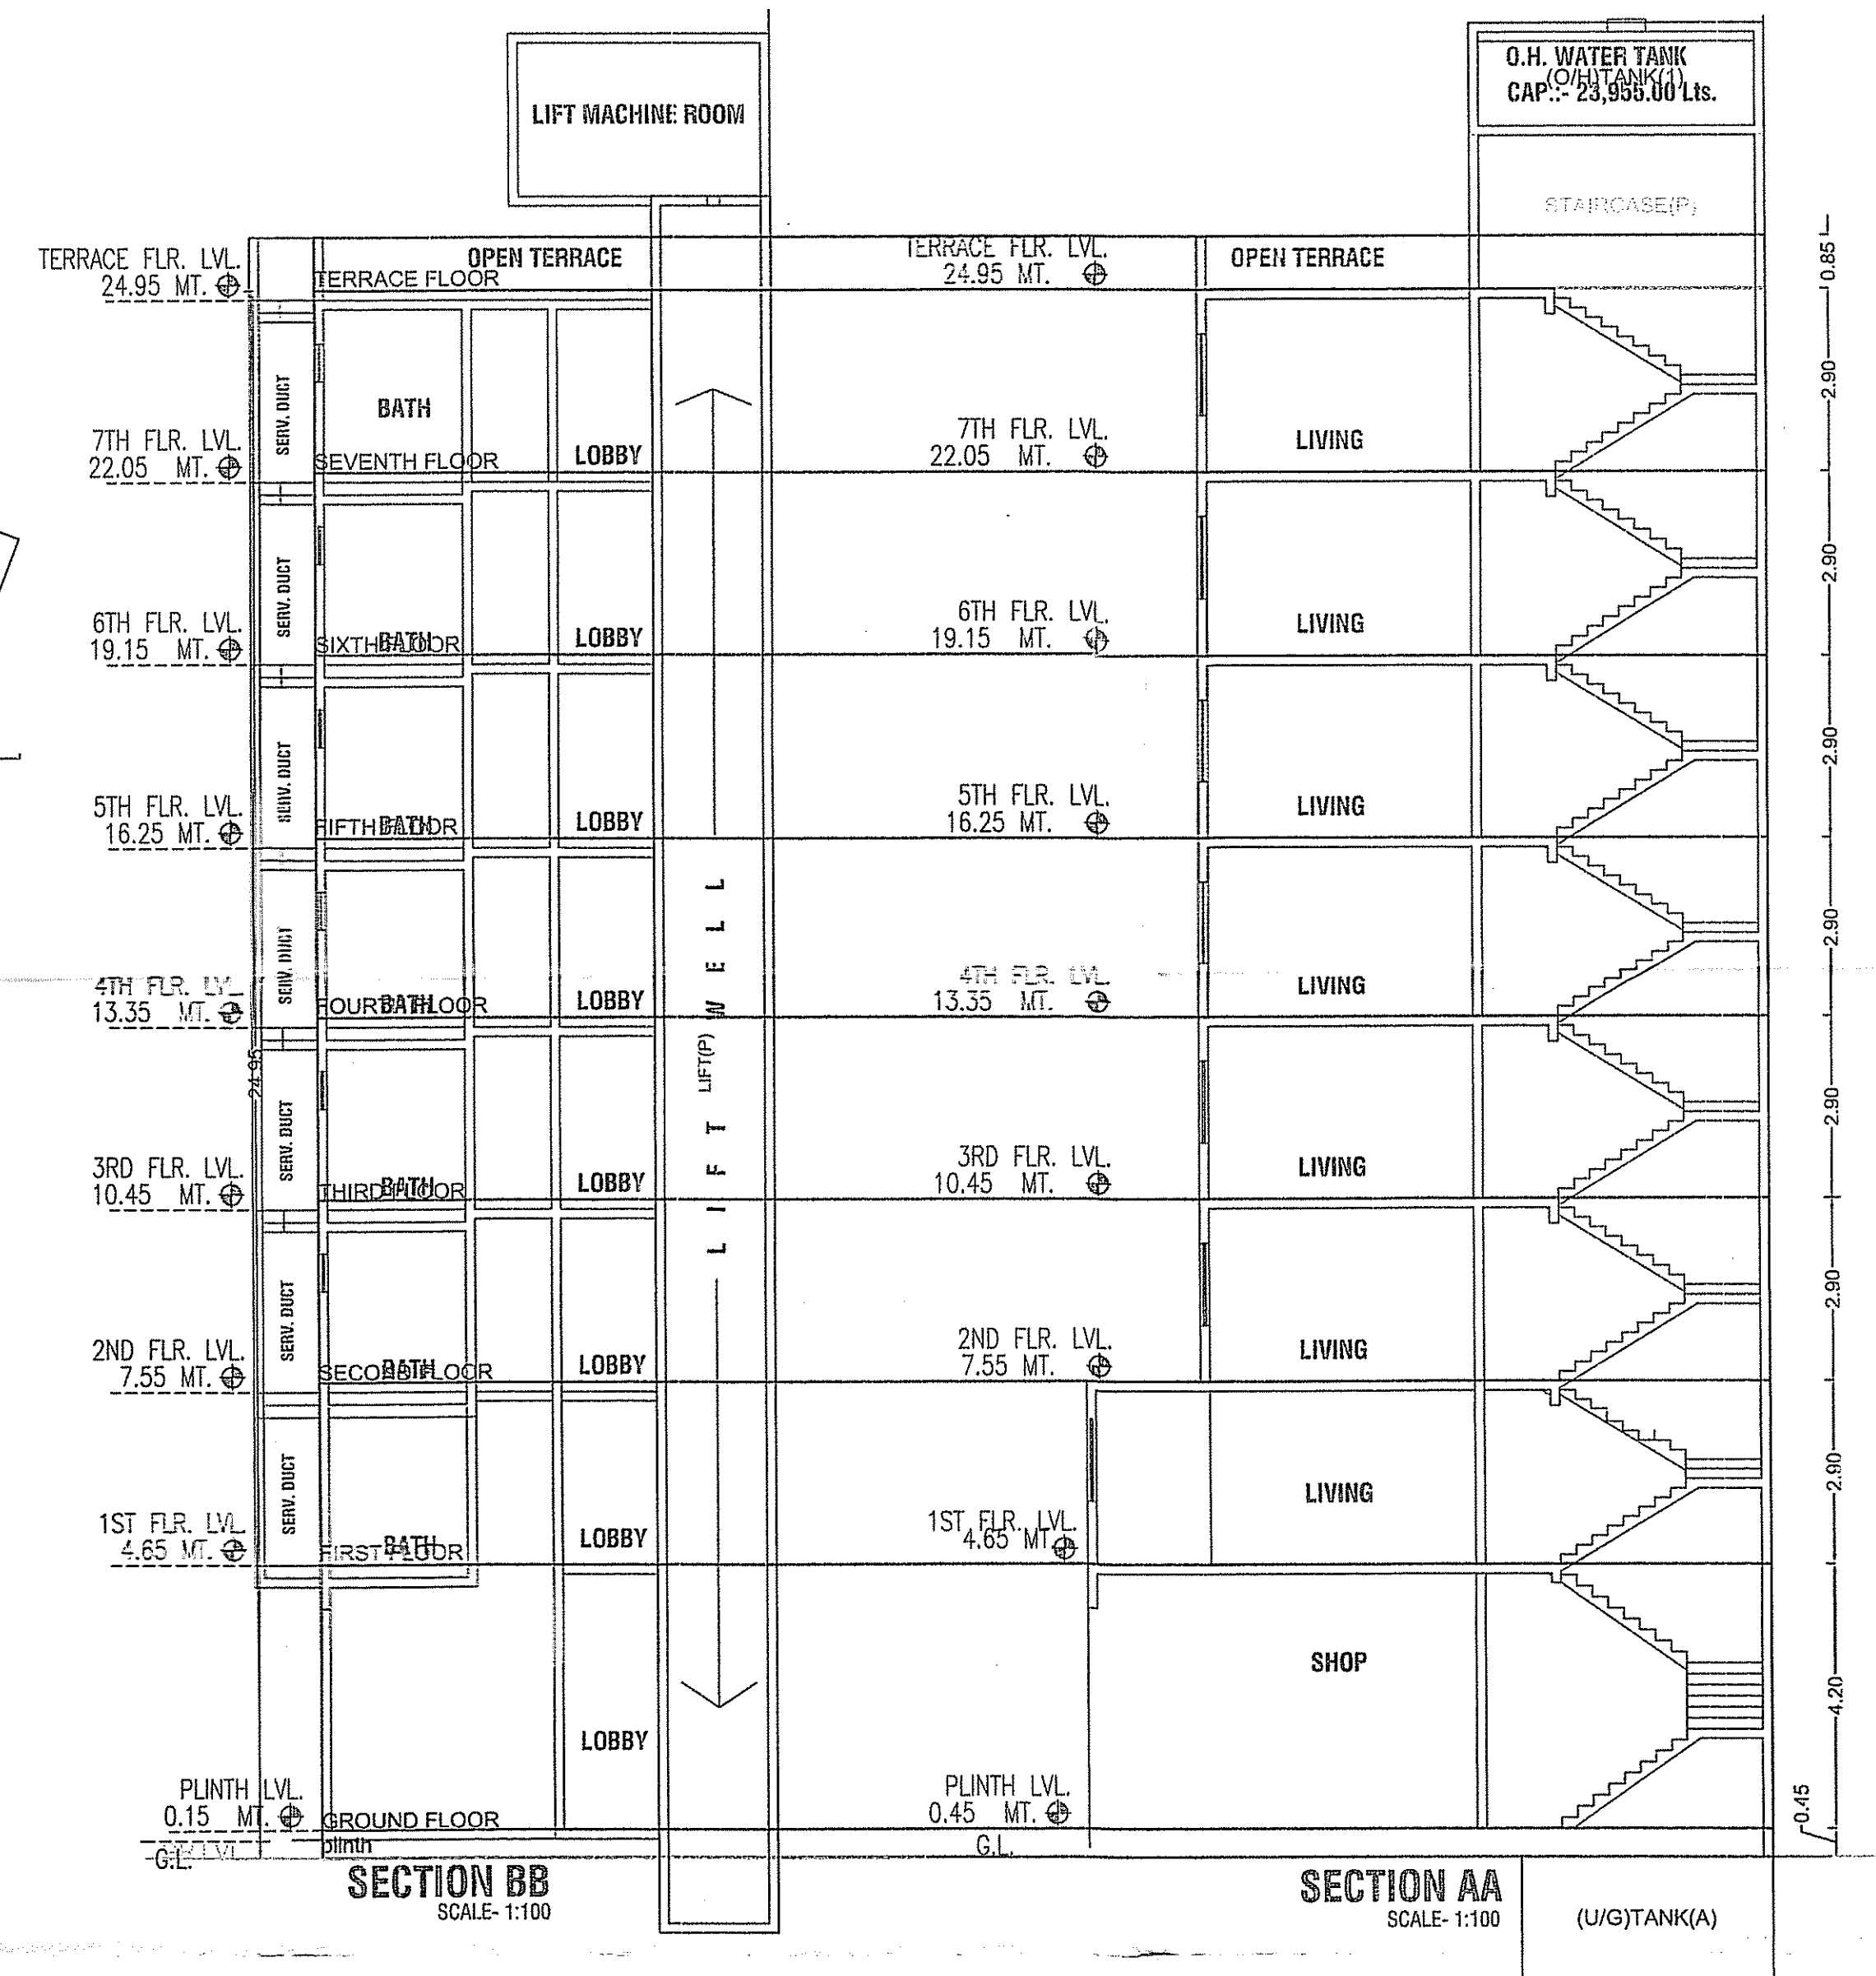

SECTION BB
SCALE- 1:100

SECTION AA
SCALE- 1:100

OWNER'S NAME / DEVELOPER NAME / POA HOLDER: M/S. SACHIN ENTERPRISES
OWNER ADDRESS: OFFICE NO.1, HORIZON HEIGHTS COMMERCIAL, 2 ND FLOOR, KASARVADAVALI, THANE
PROJECT:
Plot No.: CTS No : 128,128A
F. Plot No.: Tika No :
Survey No.: Gut No :
Village : OVALA

ARCHITECT: Prashant Arunkumar Thakkar
ARCHITECT ADDRESS: 401/4th Floor, Niti villa Behind Gurukul Society

JOB NO. DRG.NO. SCALE DRAWN BY/CHECKED BY
1:100
INWARD NO. S6C/0006/17 DATE 04-06-2021
KEY NO. SHEET NO. 3 / 3