STAMP OF APPROVAL 05/05

TOWER B

APPROVED SUBJECT TO CONDITION
APPROVED UNDER COMMENCEMENT
CERTIFICATE NO. 22-23/23

Building Inspector (Jr.Engg./Sect. Engg.) — Deputy Engineer
BUILDING PERMISSION DEPT.
ZONE-2, P.M.C.

PUNE MUNICIPAL CORPORATION BUILDING CONTROL DEPARTMENT APPROVED PUNE

ELEVATION FROM ROAD SIDE
TOWER B

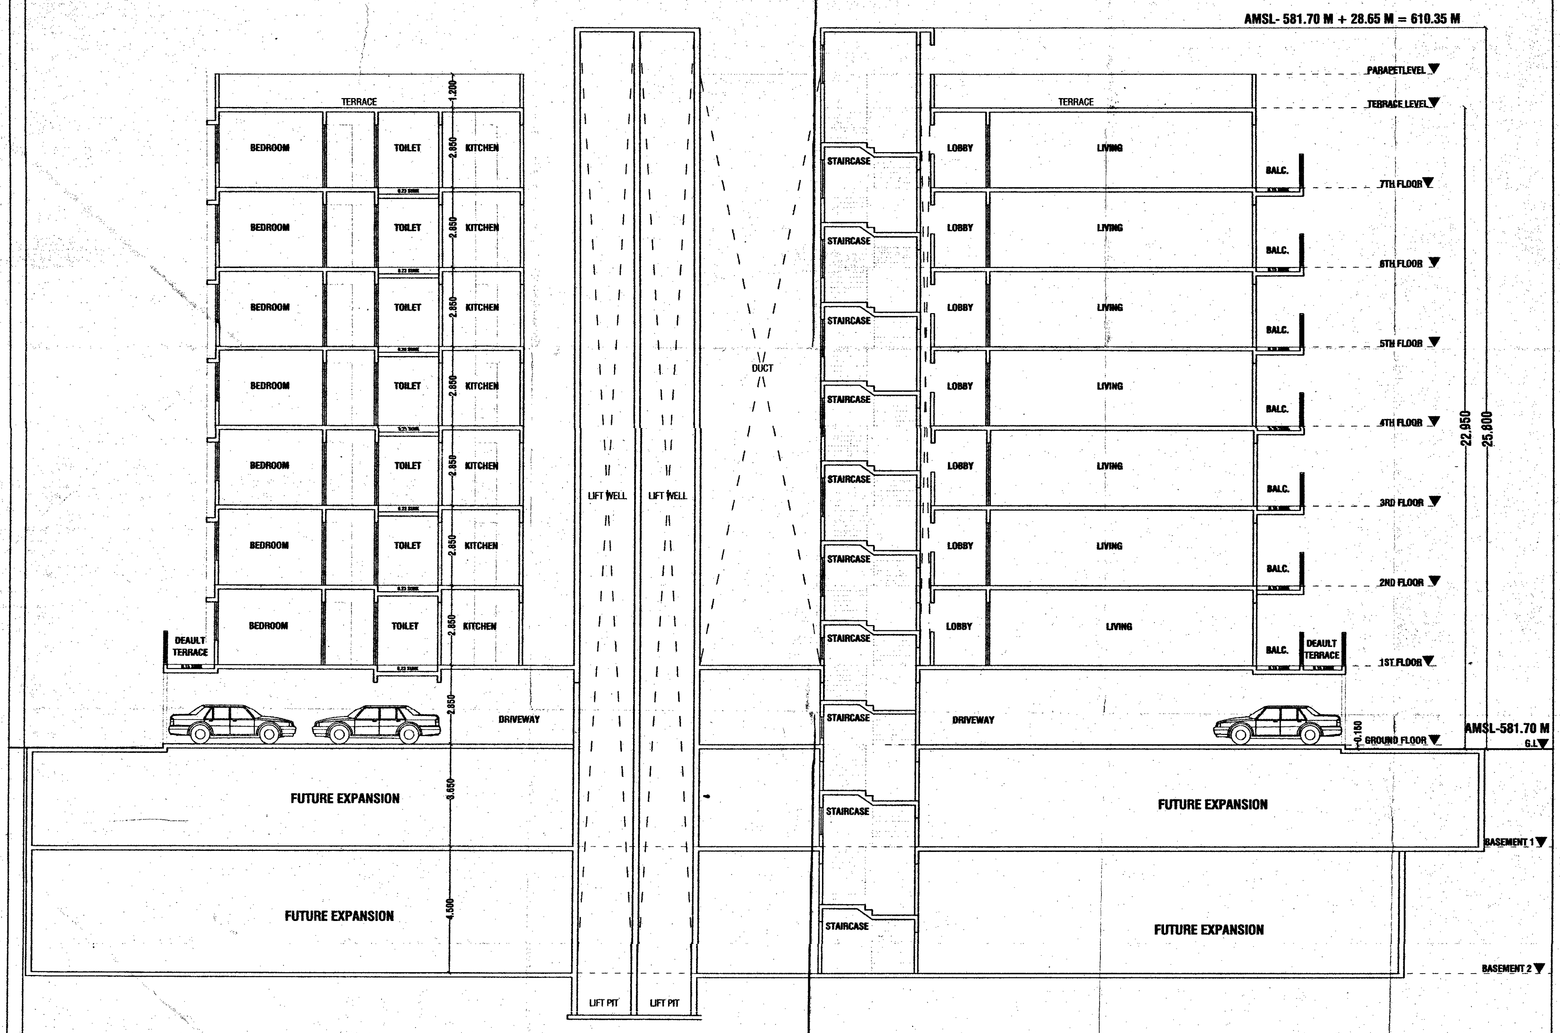

SECTION BB'

PROPOSED & REVISED BUILDING ON S.No. 57/3 (P) VADGAON BK., TAL- HAVELI, PUNE FOR : M/s. VELENTINA 7 BUILDCON LLP PARTNERSHIP FIRM THROUGH

MR. SWAPNIL CHARWAD

MR. MANGESH BELDARE

LEGEND

a) PLOT BOUNDRY SHOWN IN BLACK
b) PROPOSED WORK SHOWN IN RED
c) DRAINAGE LINE SHOWN IN RED DOTTED
d) WATER LINE SHOWN IN BLACK DOTTED
e) EXISTING WORK SHOWN IN BLUE HATCHED
f) AMENITY SPACE IN PINK HATCHEDA O/S GREEN HATCHED
g) ROAD WIDENING LINE SHOWN IN GREEN DOTTED

CERTIFICATE OF AREA

CERTIFIED THAT THE PLOT UNDER REFERENCE WAS SURVEYED BY ME ON SITE——
——AND THE DIMENSIONS OF SIDES ETC OF PLOT STATED ON PLAN ARE AS MEASURED ON SITE AND THE AREA SO WORKED OUT TALLIES WITH THE AREA STATED IN DOCUMENT OF OWNERSHIPT. F. P. SCHEME RECORD / LAND RECORD DEPT CITY SURVEY RECORDS

SIGN. OF ARCHITECT

SCALE : 1: 200	CHECKED BY :-	DWG. NO.
DATE : 13-11-2023	REVISION NO. :	05/05
APPROVED BY: AR.SHAHIN		
DRLT BY : MADHA		

N

PARVEZ JAMADAR & ASSOCIATES
architecture | liasoning | interiors
Office No.1 & 2, 2nd Floor, Shared Arcade, Opp. to Burger King
Near Pedgaon Police Chowky, Gen. Thimmaya Road, Camp, Pune. 1 INDIA
Tel.: +91 20 26362733, 26323416
E-mail: design@pjarchitects.com arch_shaha@yahoo.com
Website: www.pjarchitects.com

FILE PATH - \\server01\d_studio\beldare\57 wadgaon\01-11-23\revised(1acre basic + ancillary)\submission drawing 13-11-23.dwg